


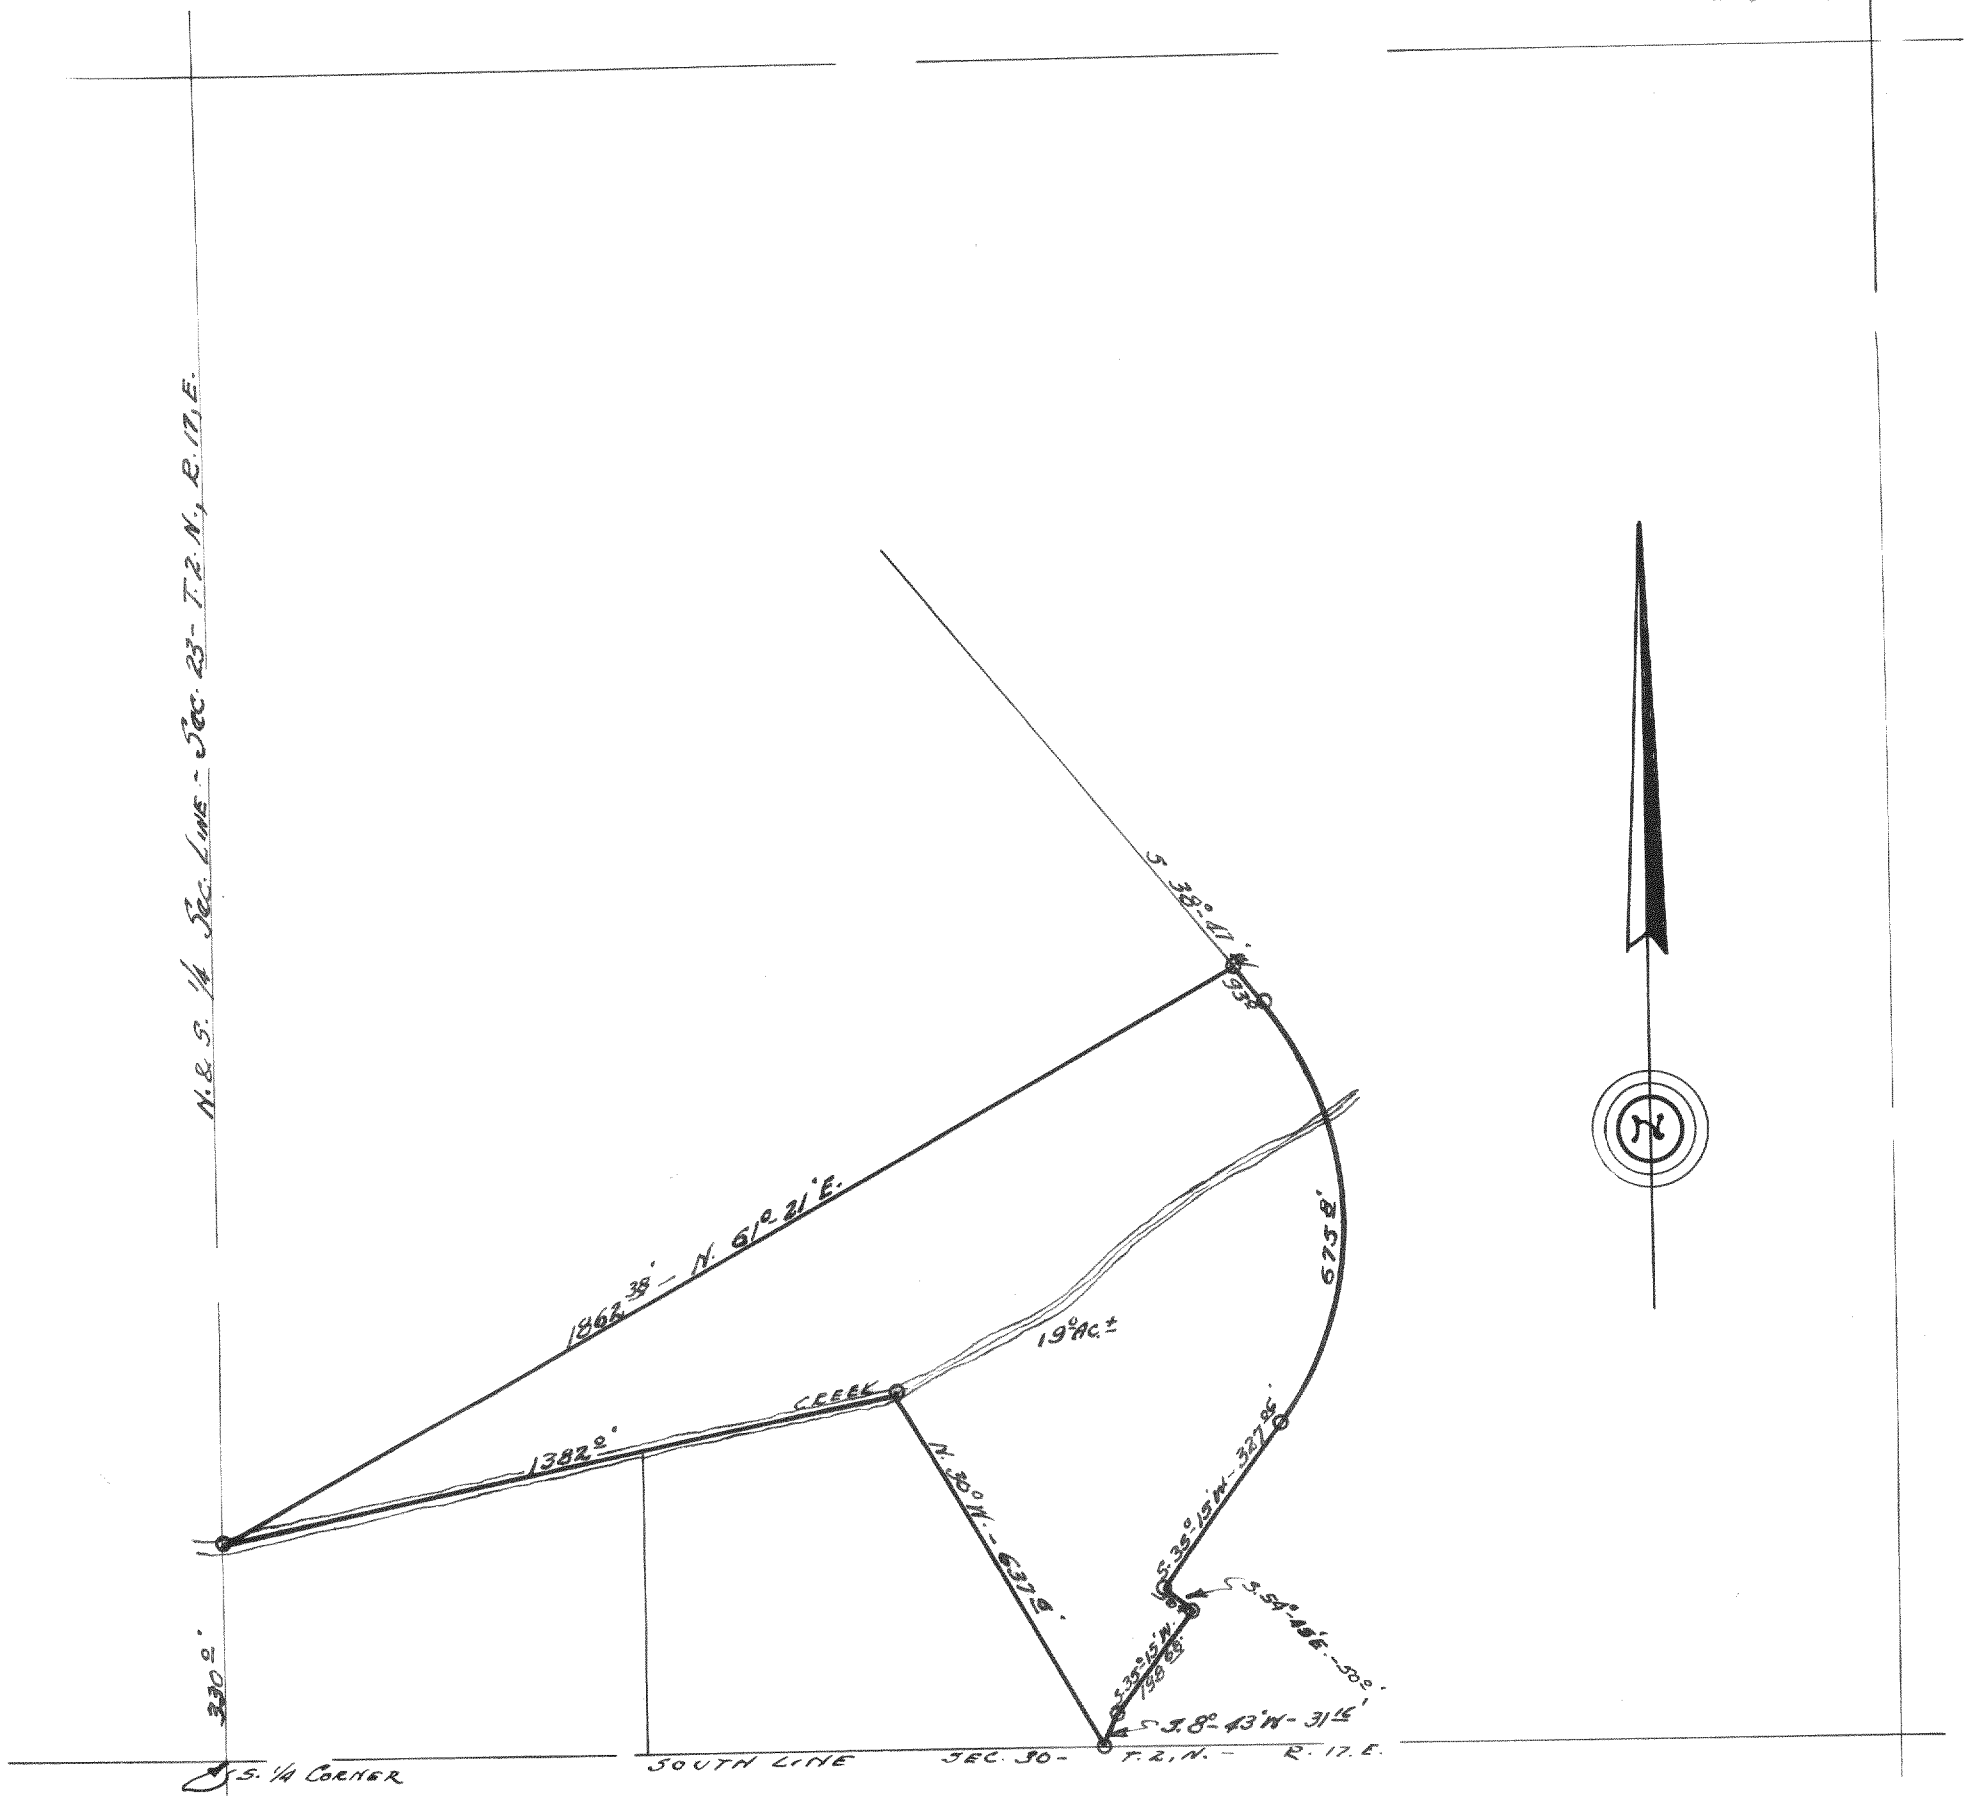

DESCRIPTION:

Commencing at a point in the north and south $\frac{1}{4}$ section line of Section 23, Town 2 north, Range 17 east, of the 4th Principal Meridian, that is 330.0 feet north of the south $\frac{1}{4}$ corner of said section, thence N. $61^{\circ} 21'$ E., 1862.38 feet to a point in the westerly line of County Trunk Highway NN, thence S. $38^{\circ} 47'$ W., along the westerly line of said highway 93.0 feet to the point of curve of a curve whose radius is 523.69 feet, thence convex southwesterly along the arc of said curve 675.80 feet to the point of tangent of said curve, thence S. $35^{\circ} 15'$ W., 327.06 feet, thence S. $54^{\circ} 45'$ E., 50.0 feet, thence S. $35^{\circ} 15'$ W. 198.68 feet, thence S. $8^{\circ} 43'$ W., 31.16 feet, thence N. 30° W., 637.6 feet to a point in the centerline of the creek, thence southwesterly along the centerline of said creek, 1382.0 feet to the place of beginning. Containing 19.0 acres more or less.

CERTIFICATE:

I, hereby certify that I have on this the 5th day of July, surveyed the above described property, according to the official records on file in the office of the Recorder of Deeds in and for Walworth County, Wisconsin, and find that the measurements and bearings of the boundary line of said property as taken at the site on this day, substantially agree with those in said official record and that no encroachments exist. Surveyed this 5th day of July 1951. Signed and sealed on this the 6th day of July 1951.

Joseph M. Biagi. Professional Engineer. Elkhorn Wisconsin.

G-23-9A

217-56B