


DUNHAM & RASMUSSEN
SURVEYING & ENGINEERING
DELAVER, WISCONSIN

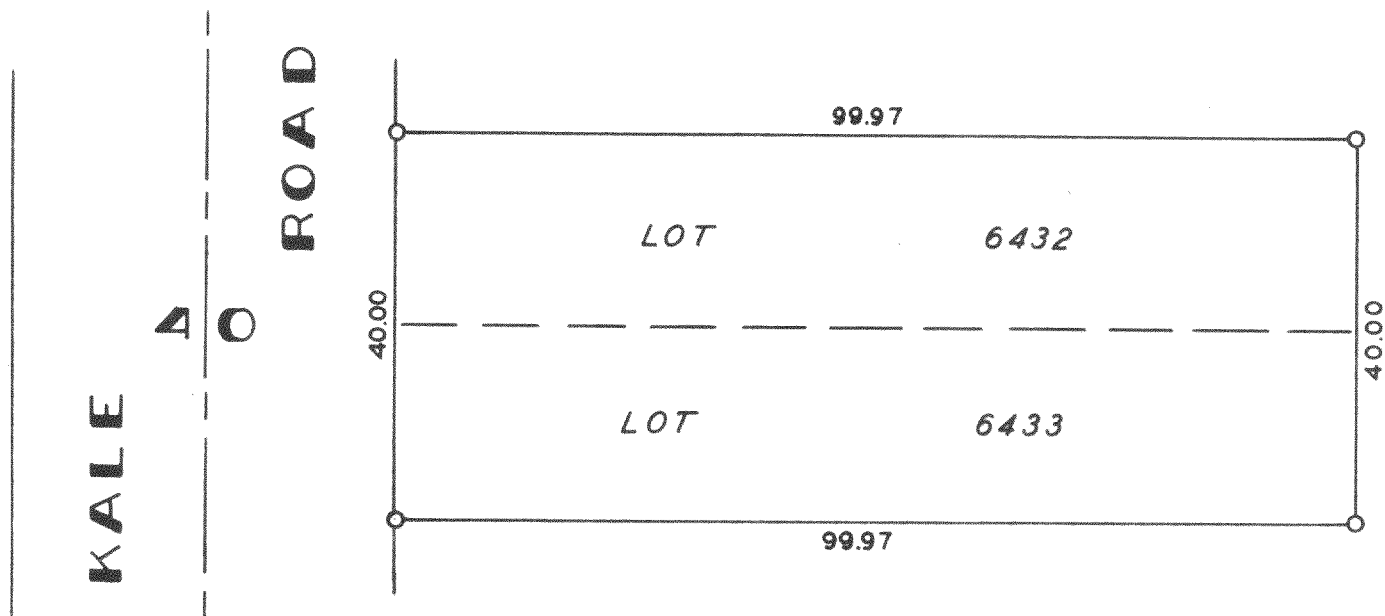

SCALE ~ 1" = 20'
O = IRON PIPE

Plat of survey of Lots 6432 and 6433 of Lake
Como Beach Subdivision, T 2 N R 17 E, Walworth County,
Wisconsin.
August 31, 1961


George T. Dunham, Surveyor