


DUNHAM SURVEYING, S.C.
SURVEYING & SUBDIVIDING
DELAVER, WISCONSIN 53115



Walnut Road

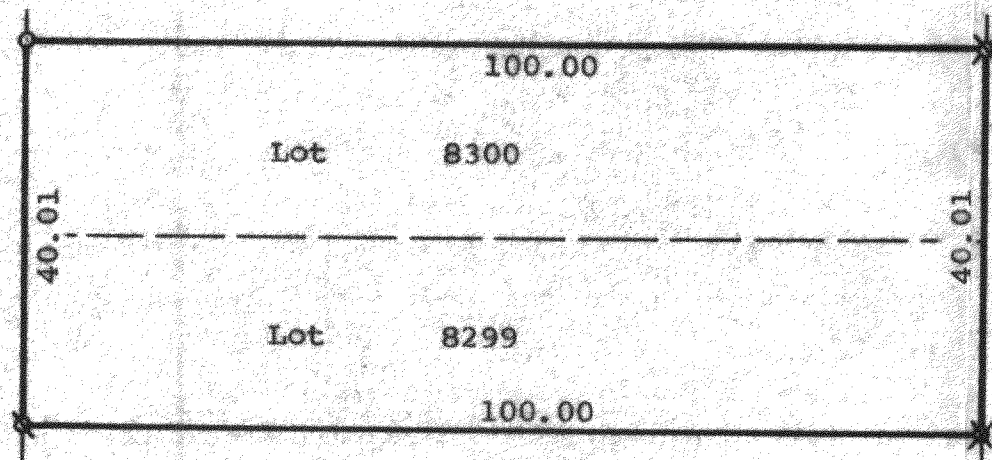

Scale - 1" = 20'
⊗ = Iron Pipe Found
○ = Iron Pipe Set
⊗ = Iron Pipe Found and Reset

STATE OF WISCONSIN)
COUNTY OF WALWORTH) SS

I, James M. Dunham, Surveyor, certify that I have surveyed the property described as follows,

Lots 8299 and 8300 in Block 142 of Lake Como Beach Subdivision, located in Section 21, T2N, R17E, Walworth County, Wisconsin, and that the above map is a true representation thereof and shows the size and location of the property, its exterior boundaries, the location of all visible structures and dimensions of all principal buildings thereon, boundary fences, apparent easements, if any.

This survey is made for the use of the present owners of the property, and also those who purchase, mortgage, or guarantee the title thereto within one (1) year from date hereof.
October 8, 1980

James M. Dunham
James M. Dunham, Surveyor

