


FARRIS, HANSEN & COOPER, INC.


ENGINEERING, SURVEYING AND LAND PLANNING
715 W. WALWORTH ST. - P.O. BOX 487 - ELKHORN, WI 53121
OFFICE: 414/723-2098

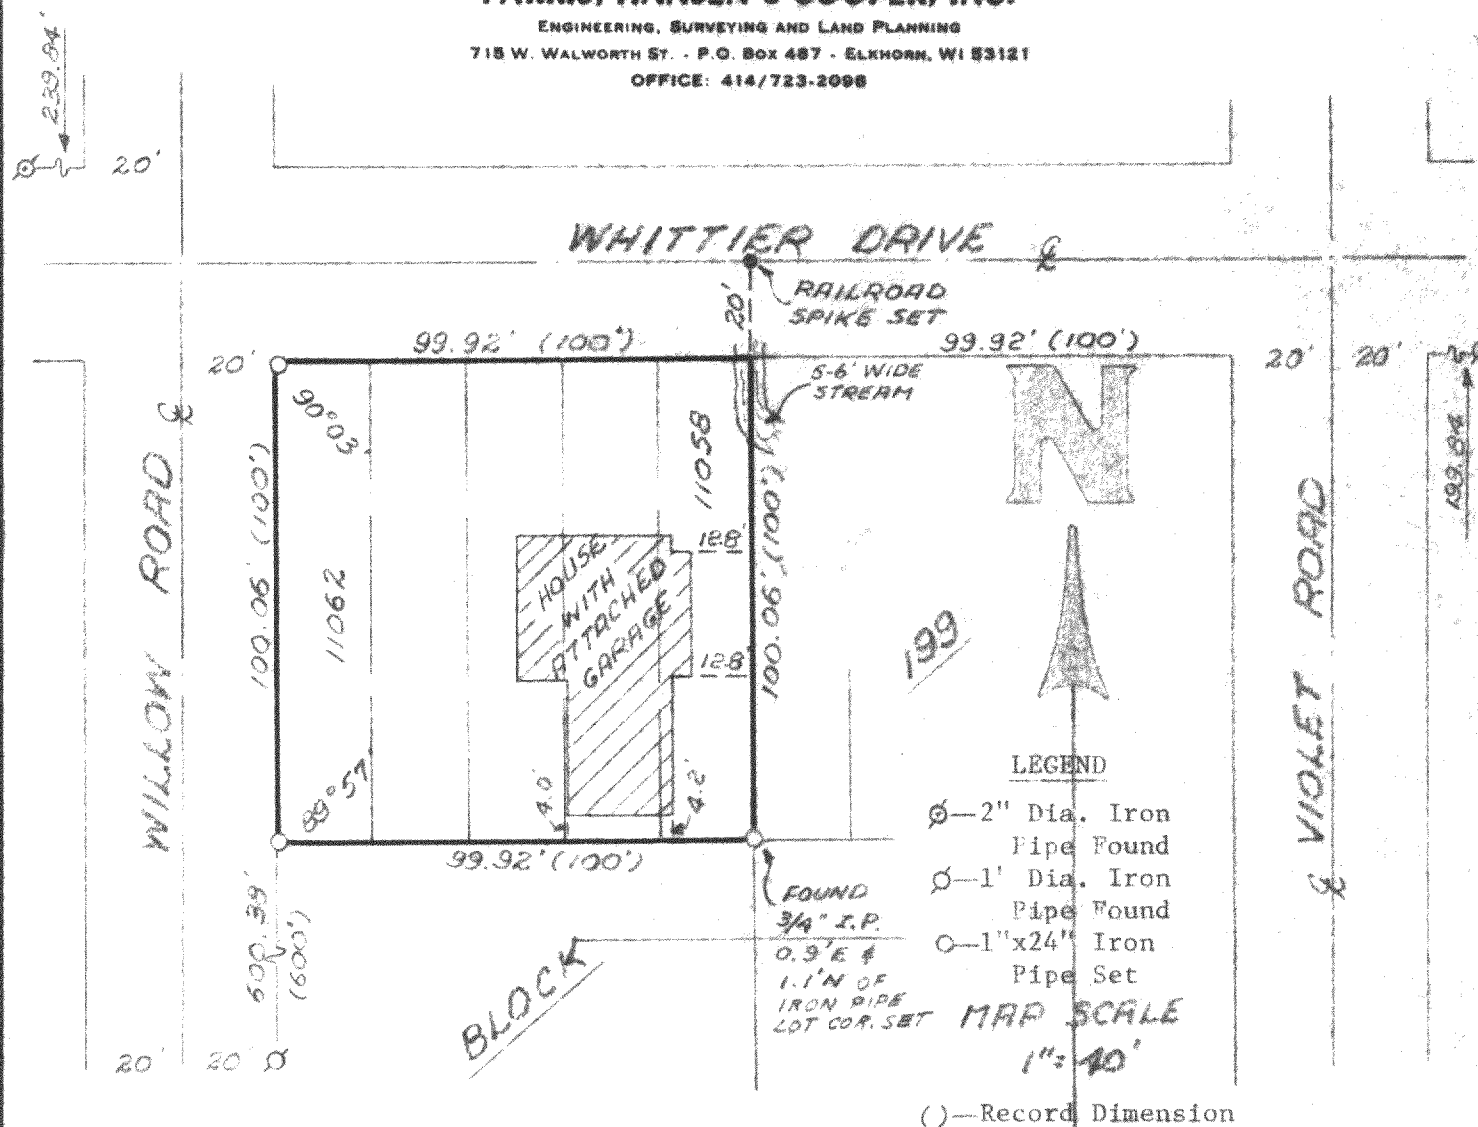

PLAT OF SURVEY OF

LOTS 11058-11062, BLOCK 199, LAKE COMO BEACH SUBDIVISION, TOWN 2 NORTH, RANGE 17 EAST, WALWORTH COUNTY, WISCONSIN.

I HEREBY CERTIFY that at the request of Casey Mikrut I have surveyed LOTS 11058-11062 of Lake Como Beach Subdivision and that this Plat of Survey is a true and accurate representation of the lot lines and buildings located on said property to the best of my professional knowledge and belief.

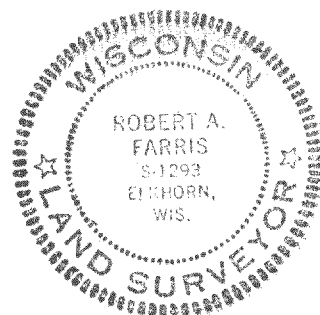

Robert A. Farris
Robert A. Farris, RLS No. 1293

Dated this 14 day of November 1982.