


KOLB LAND CONSULTING, INC.
LAND SURVEYING • SUBDIVIDING • LAND PLANNING

LAKE GENEVA, WISCONSIN 53147


WHITEWATER, WISCONSIN 53190

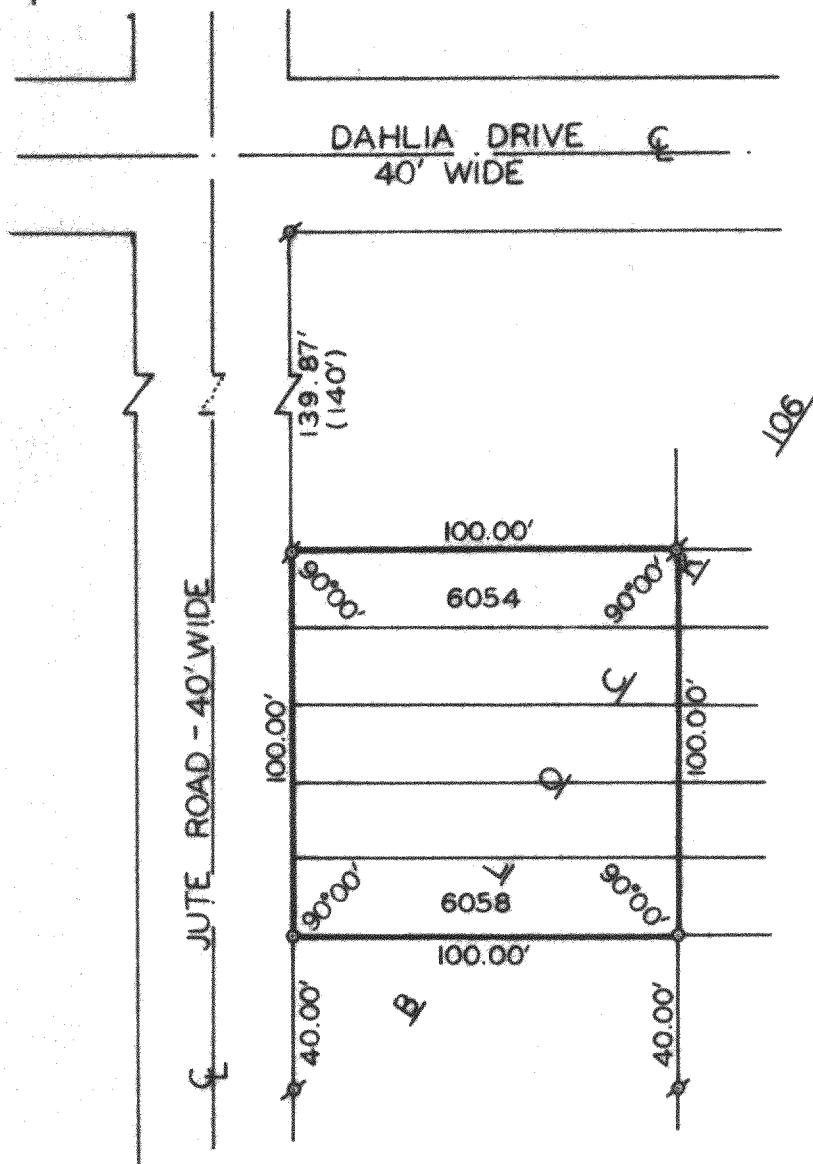

PLAT OF SURVEY OF

LOTS 6054-6058, BLOCK 106, LAKE COMO
BEACH SUBDIVISION, TOWN 2 NORTH,
RANGE 17 EAST, WALWORTH COUNTY,
WISCONSIN.

OWNER: MICHAEL GAGLIONE
ROUTE 2
LAKE GENEVA, WI 53147

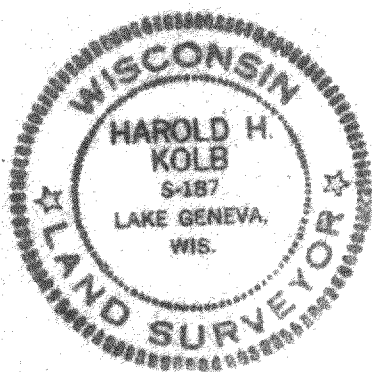

N



SCALE: 1"=50'

LEGEND

σ - FOUND IRON PIPE
o - SET IRON PIPE
() - RECORDED AS

I, HAROLD H. KOLB, DO HEREBY CERTIFY THAT I HAVE
SURVEYED THE PROPERTY HEREON DESCRIBED ACCORDING
TO THE OFFICIAL RECORDS AND THAT THE PLAT HEREON
IS A CORRECT REPRESENTATION OF THE LOT LINES TO
THE BEST OF MY KNOWLEDGE AND BELIEF.

Harold H. Kolb

HAROLD H. KOLB
WISCONSIN REGISTERED LAND SURVEYOR, S-187

DATE *May 7, 1980*

JLCB-1249

217-572