
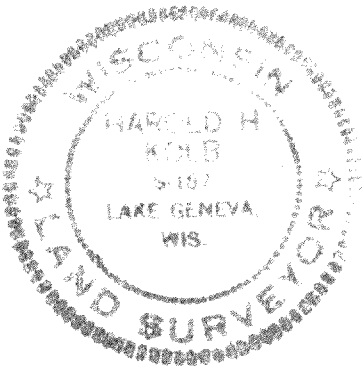


KOLB LAND CONSULTING, INC.
LAND SURVEYING • SUBDIVIDING • LAND PLANNING

LAKE GENEVA, WISCONSIN 53147


WHITEWATER, WISCONSIN 53190

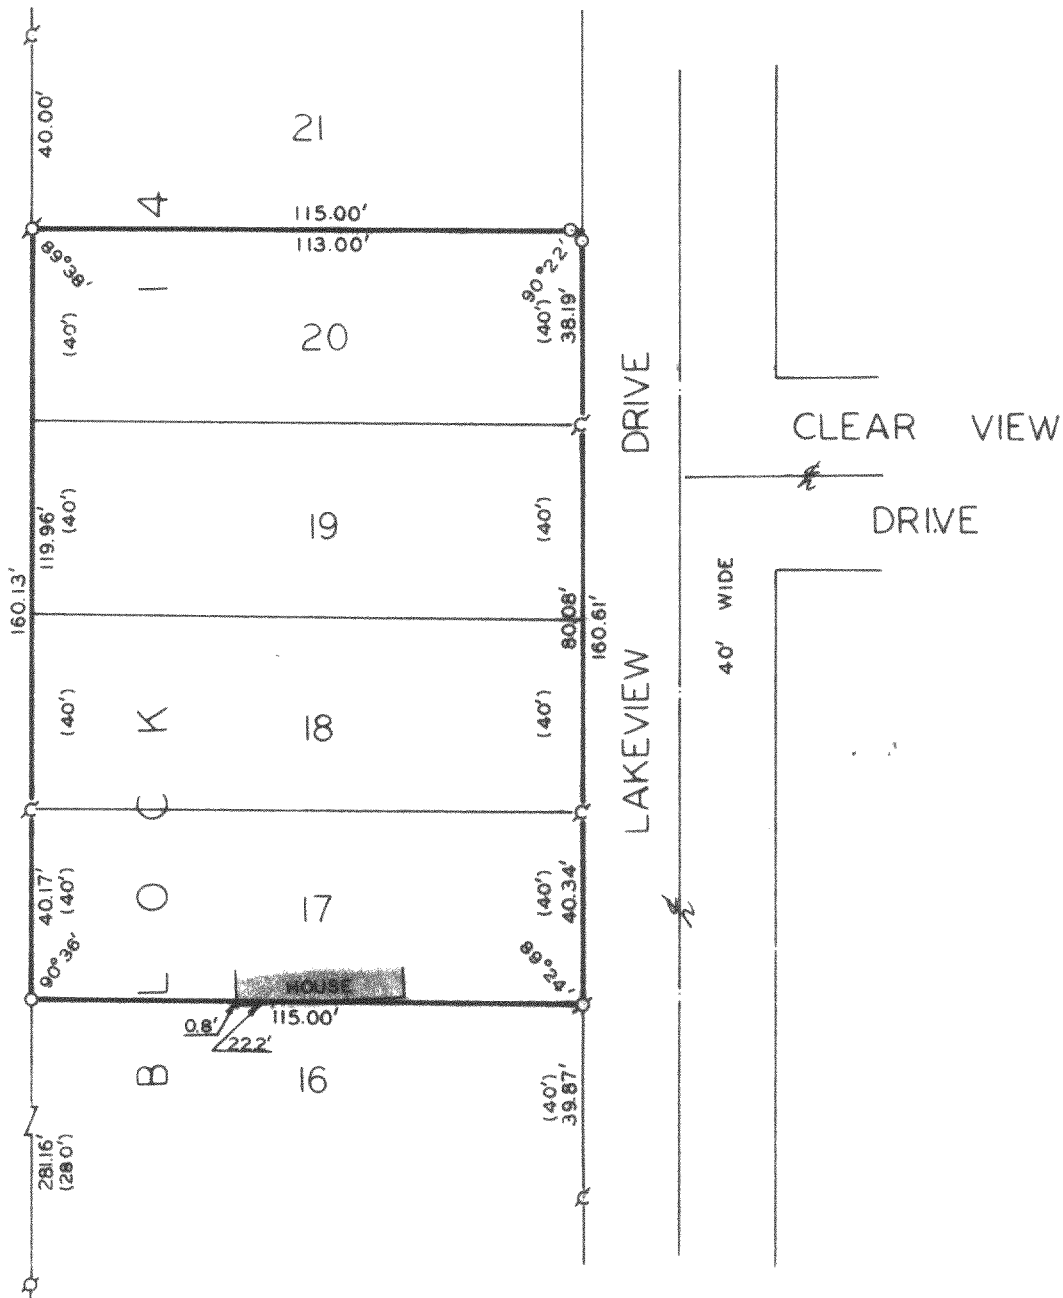

PLAT OF SURVEY OF

LOTS 17-20, BLOCK 14, SUNSET
HILLS, A SUBDIVISION LOCATED
IN TOWN 2 NORTH, RANGE 17
EAST, WALWORTH COUNTY,
WISCONSIN.

OWNER: ALBERT D'ANNA
ORDERED BY: STURGE TAGGART AGENCY
LAKE GENEVA, WI 53147

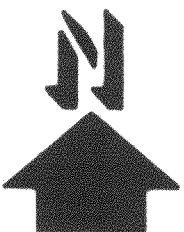

LEGEND

SCALE: 1" = 40'

- ⊙ - IRON PIPE FOUND
- - IRON PIPE PLACED
- ⋈ - POSEY PIN FOUND
- () - RECORDED AS

I, HAROLD H. KOLB, DO HEREBY CERTIFY THAT I HAVE
SURVEYED THE PROPERTY HEREON DESCRIBED ACCORDING
TO THE OFFICIAL RECORDS, AND THAT THE PLAT HEREON
IS A CORRECT REPRESENTATION OF THE LOT LINES TO
THE BEST OF MY KNOWLEDGE AND BELIEF.

Harold H. Kolb
HAROLD H. KOLB
WISCONSIN REGISTERED LAND SURVEYOR, S-187
DATE Sept. 12, 1980

217-572-K