


FARRIS, HANSEN & COOPER, INC.

ENGINEERING, SURVEYING AND LAND PLANNING
715 W. WALWORTH ST. - P.O. BOX 487 - ELKHORN, WI 53121
OFFICE: 414/723-2098

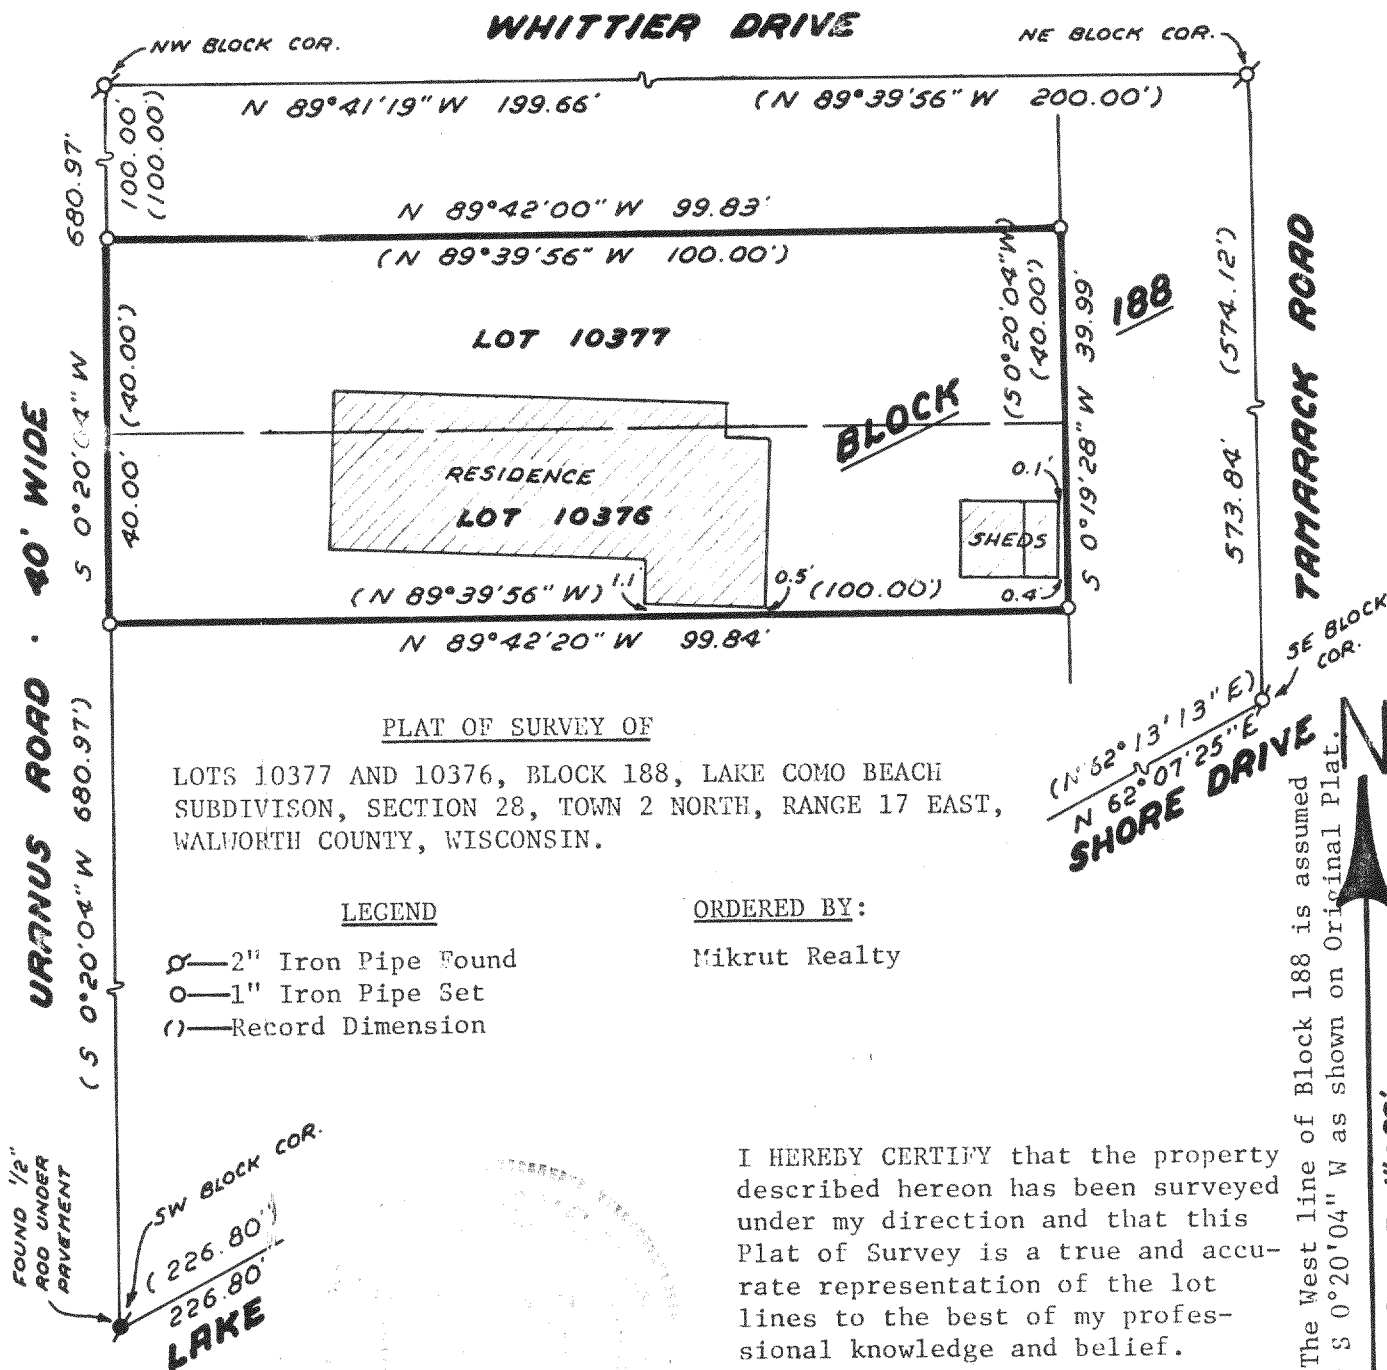

I HEREBY CERTIFY that the property described hereon has been surveyed under my direction and that this Plat of Survey is a true and accurate representation of the lot lines to the best of my professional knowledge and belief.

Harry A. Huston
Harry A. Huston, RLS No. 00316
Dated this 27th day of JAN., 1982.

NOTE: The West line of Block 188 is assumed to bear S 0°20'04" W as shown on Original Plat.

SCALE: 1"=20'

DRAWING NUMBER 1926

217-574-F

JLKB-2247