


PLAT OF SURVEY

OF


LOTS 10506 - 10521, BLOCK 190, LAKE COMO BEACH, A
SUBDIVISION LOCATED IN SECTION 28, T2N, R17E,
WALWORTH COUNTY, WISCONSIN

ORDERED BY: MR. ROBERT WOLLER
10501 URANUS
LAKE COMO, WIS.

SURVEYED BY: JENSEN SURVEYING &
MAPPING, S.C.
P.O. BOX 322
ELKHORN, WIS. 53121

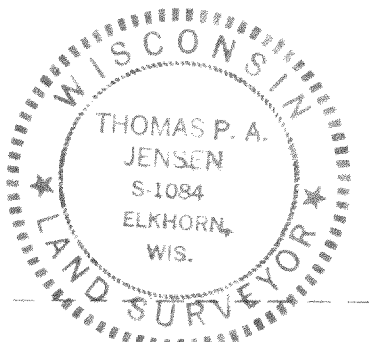

LINCOLN ^{50'} WIDE DR.
(REC. AS 589°39'56"E)

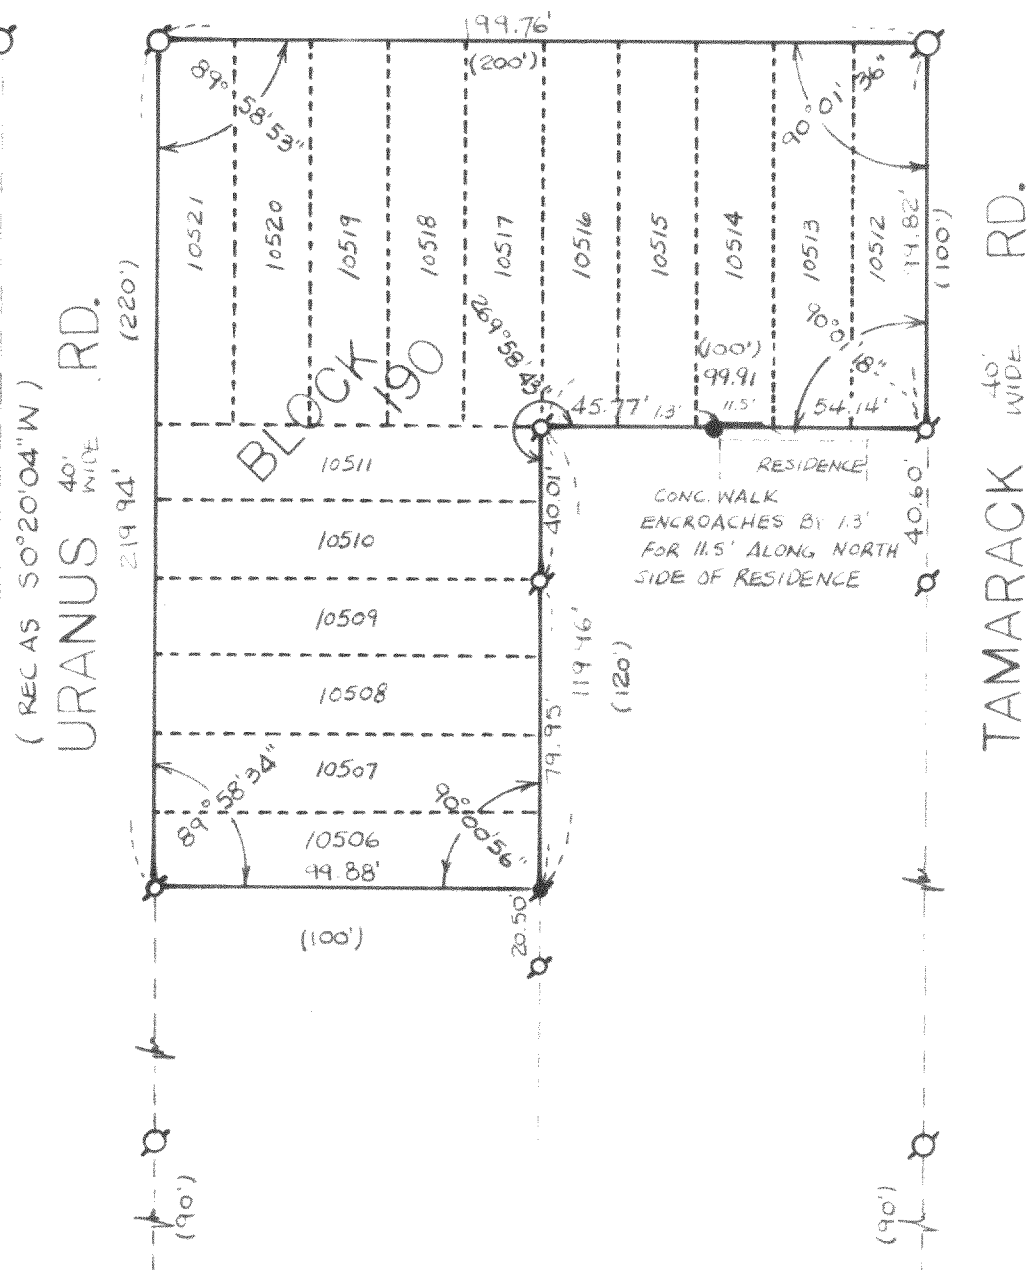

SCALE 1" = 50'

LEGEND

- ~ 2" IRON PIPE FOUND
- ⊗ ~ 1" IRON PIPE FOUND
- ~ 1/2" SQ. IRON ROD FOUND
- ~ 3/4" DIA. IRON ROD SET

() - RECORDED AS

LONGFELLOW ^{40'} WIDE DR.

I HEREBY CERTIFY THAT THE ABOVE DESCRIBED PROPERTY HAS BEEN SURVEYED
UNDER MY DIRECTION AND THAT THE PLAT SHOWN HEREON IS AN ACCURATE SURVEY
AND A TRUE REPRESENTATION THEREOF, AND CORRECTLY SHOWS THE BOUNDARY
LINES OF SAID PROPERTY

DATED MAY 20TH, 1982

Thomas P. A. Jensen
THOMAS P. A. JENSEN S-1084