

1" = IRON PIPE FOUND

2" = IRON PIPE SET

3" = RECORD DIMENSION

4" = CONC. REBAR FOUND

5-1084, 1972


FARRIS, HANSEN & COOPER, INC.

ENGINEERING, SURVEYING AND LAND PLANNING

715 W. WALWORTH ST. - P.O. BOX 487 - ELKHORN, WI 53121

OFFICE: 414/723-2098

PLAT OF SURVEY OF LOTS 11510 - 11517 OF BLOCK
207 OF LAKE COMO BEACH SUBDIVISION, SECTION 29,
TOWN 2 NORTH, RANGE 17 EAST, WALWORTH COUNTY,
WISCONSIN

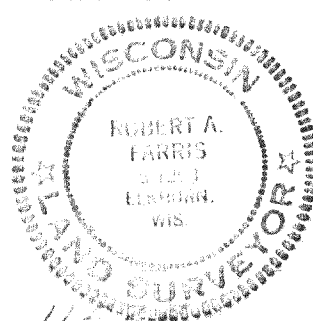


0.00 N. 3
0.36 E.
OF CORNER

MAP

SCALE

1" = 40'

ORDERED BY
MINNETONKA

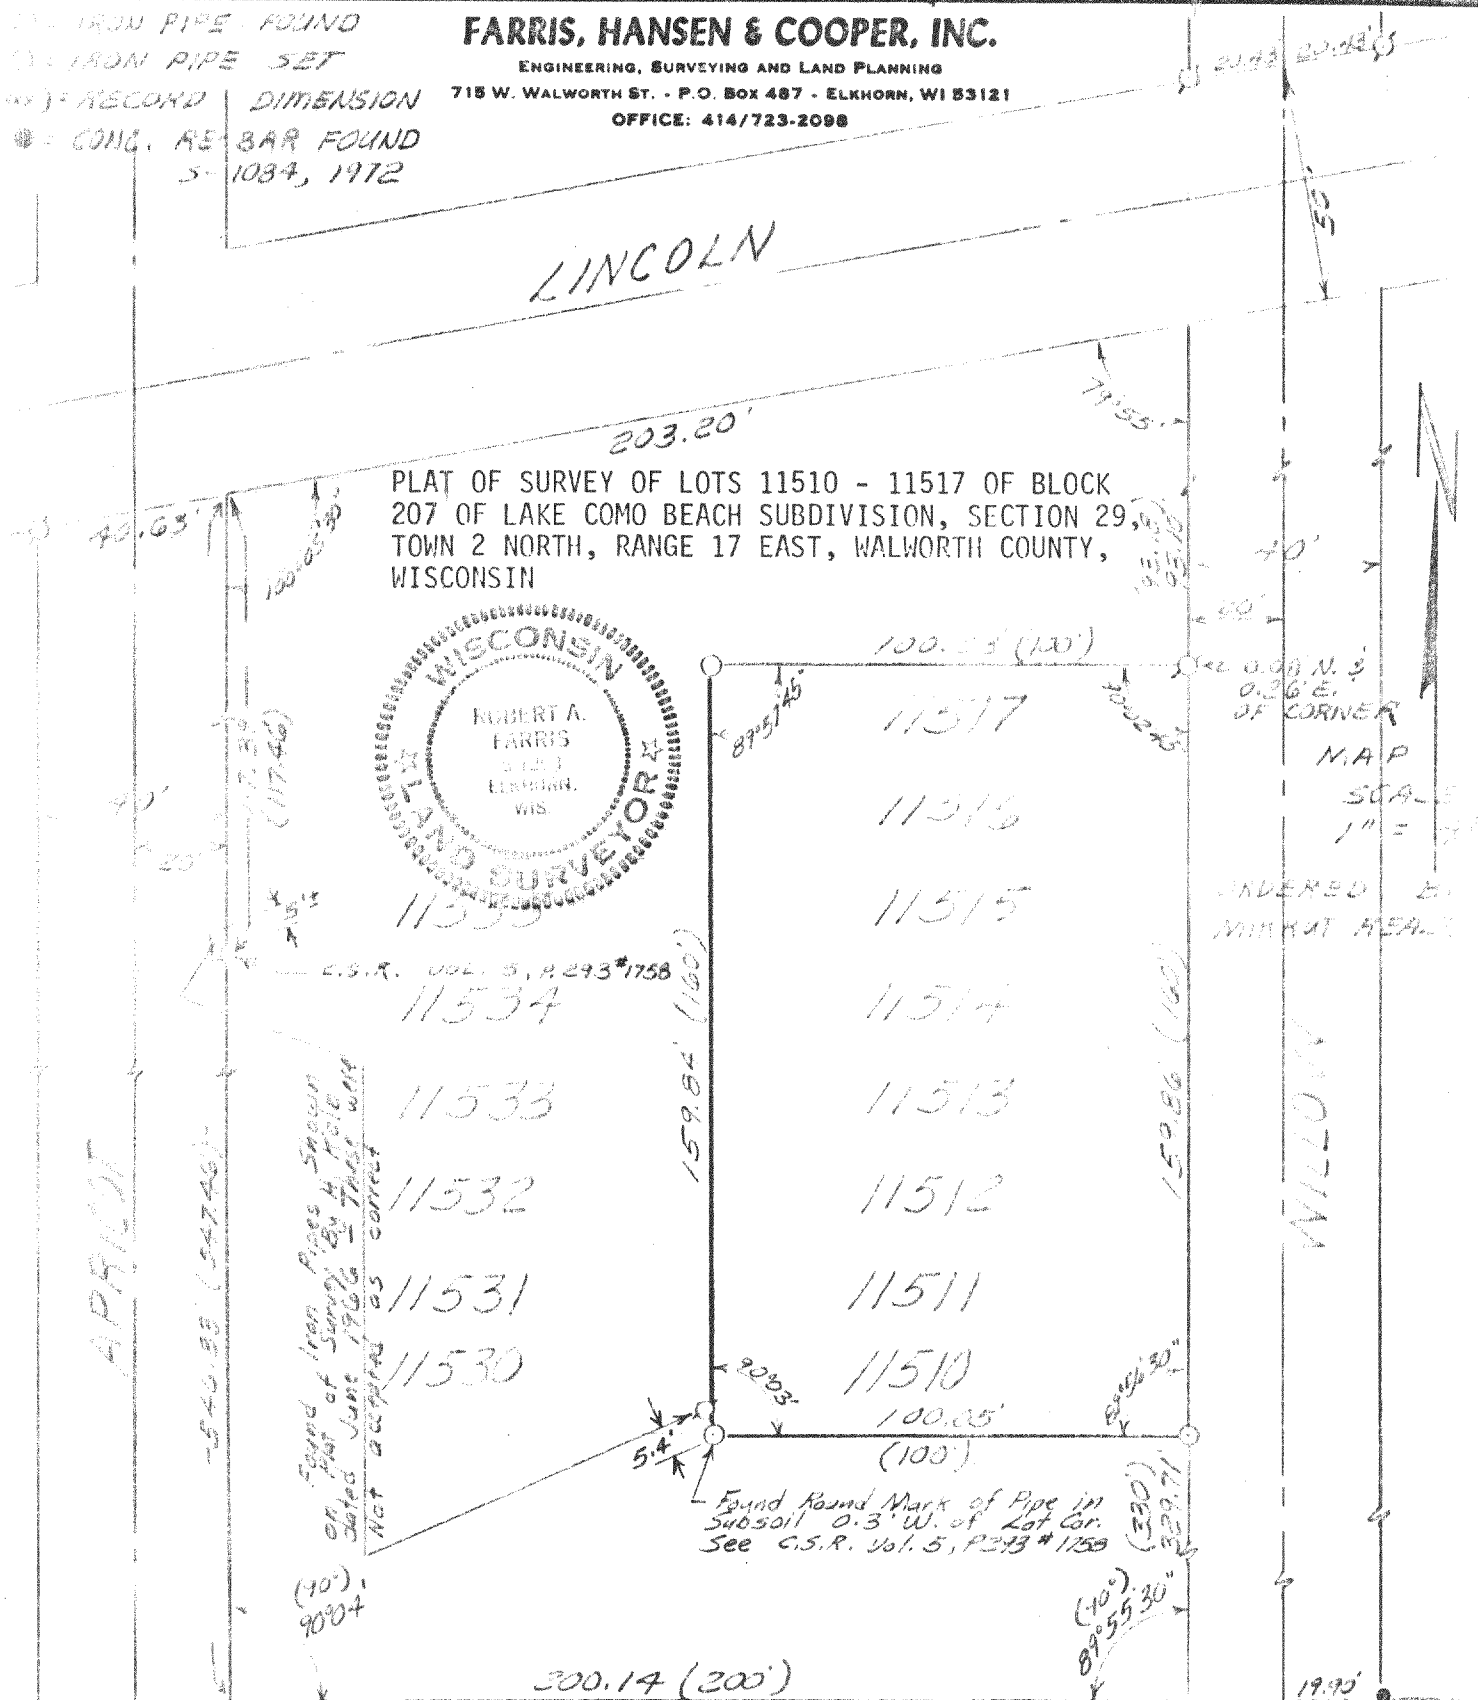

I HEREBY CERTIFY that I have surveyed the lands described hereon and that this PLAT OF SURVEY is a true and accurate representation of the boundary lines to the best of my professional knowledge and belief. DATED THIS 6th DAY OF OCTOBER, 1981

LONGFELLOW

Robert A. Farris

DRAWING NUMBER 1895-2

ILCB 2505 & 2504 A

217-576-F ✓