


PLAT OF SURVEY OF LOTS 12228 TO 12239
 INCLUSIVE, BLOCK 218, FIFTH MAP OF LAKE
 COMO BEACH, A SUBDIVISION LOCATED IN SECTIONS
 21, 22, 28 & 29, T2N R17E, WALDORF COUNTY, WIS.

I CERTIFY THAT I HAVE SURVEYED THE ABOVE DESCRIBED LAND
 AND THAT THE PLAT HEREON IS A CORRECT REPRESENTATION OF THE
 LOT LINES OF THE SAID PROPERTY TO THE BEST OF MY
 KNOWLEDGE AND BELIEF.



APRIL 18, 1983

Thomas P. A. Jensen
 THOMAS P. A. JENSEN
 JENSEN SURVEYING
 &
 MAPPING, S.C.
 P.O. BOX 322
 ELKHORN, WIS.
 53121
 414-723-3434

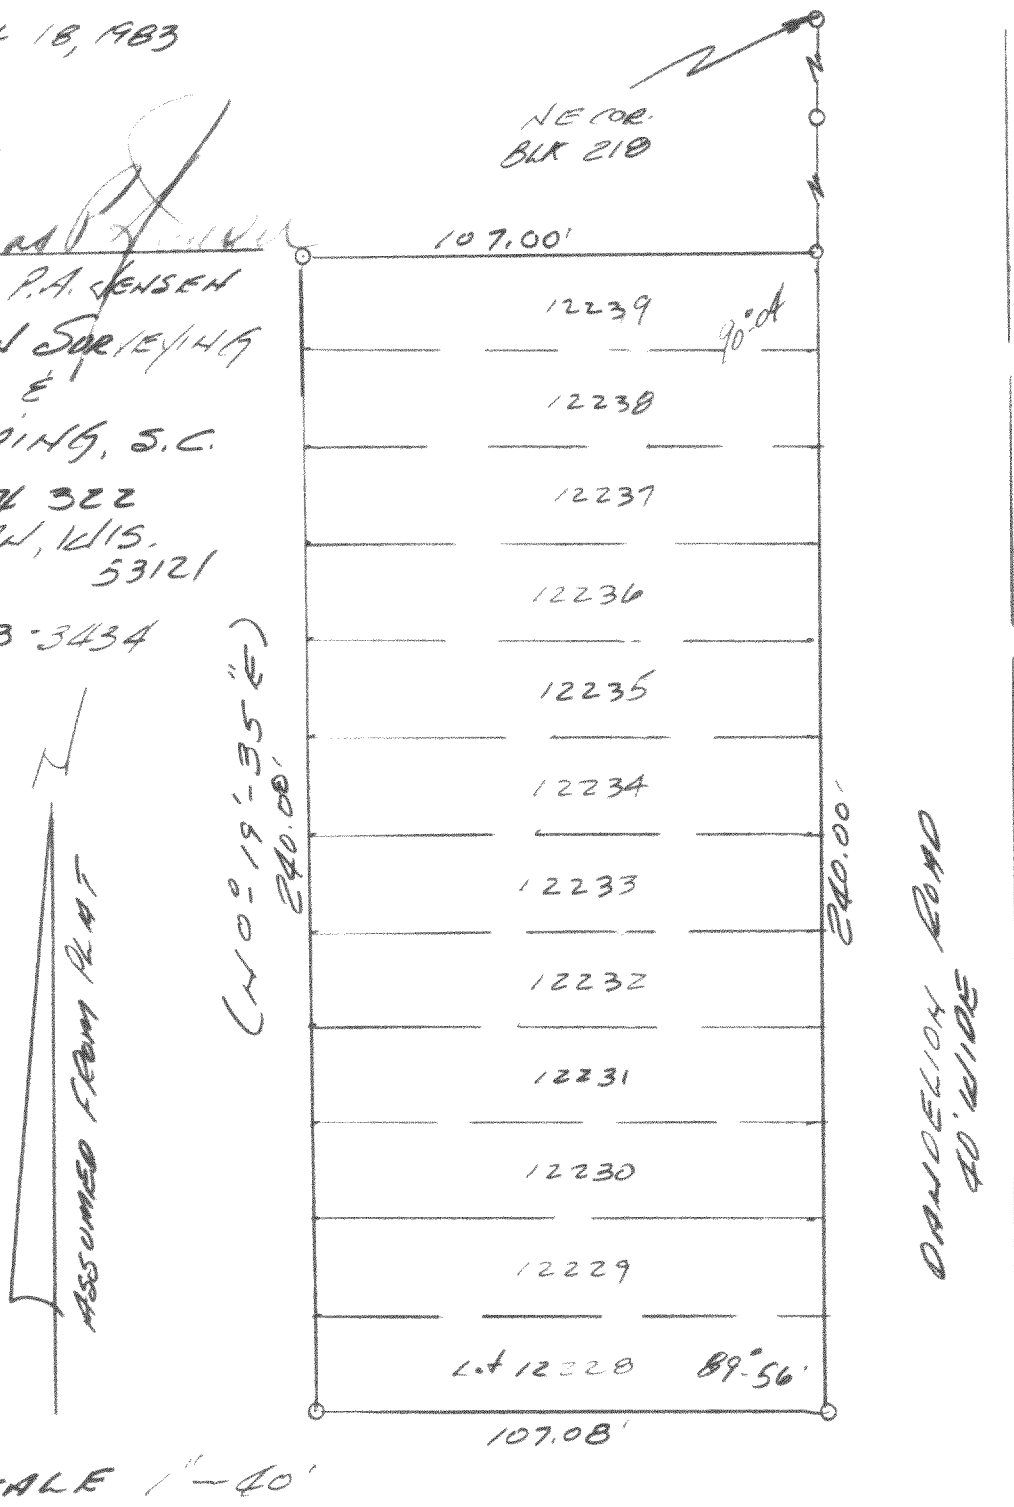

SURVEYED FOR: A. SHELDON
 LAKE GENEVA, WIS.
 () ~ RECORDED AS
 O ~ FOUNDIRON PIPE

NOTE: HOUSE IS WELL
 WITHIN LOT LINES.

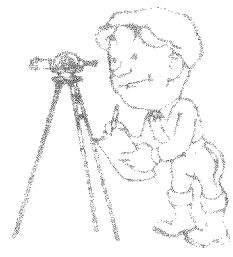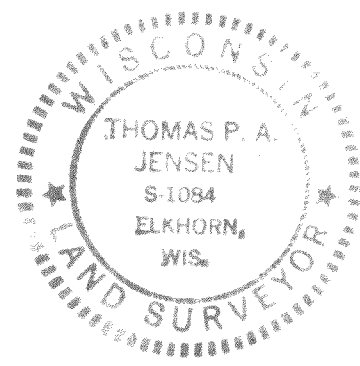

217-578J