


KOLB LAND CONSULTING, INC.
LAND SURVEYING • SUBDIVIDING • LAND PLANNING

LAKE GENEVA, WISCONSIN 53147

WHITEWATER, WISCONSIN 53190

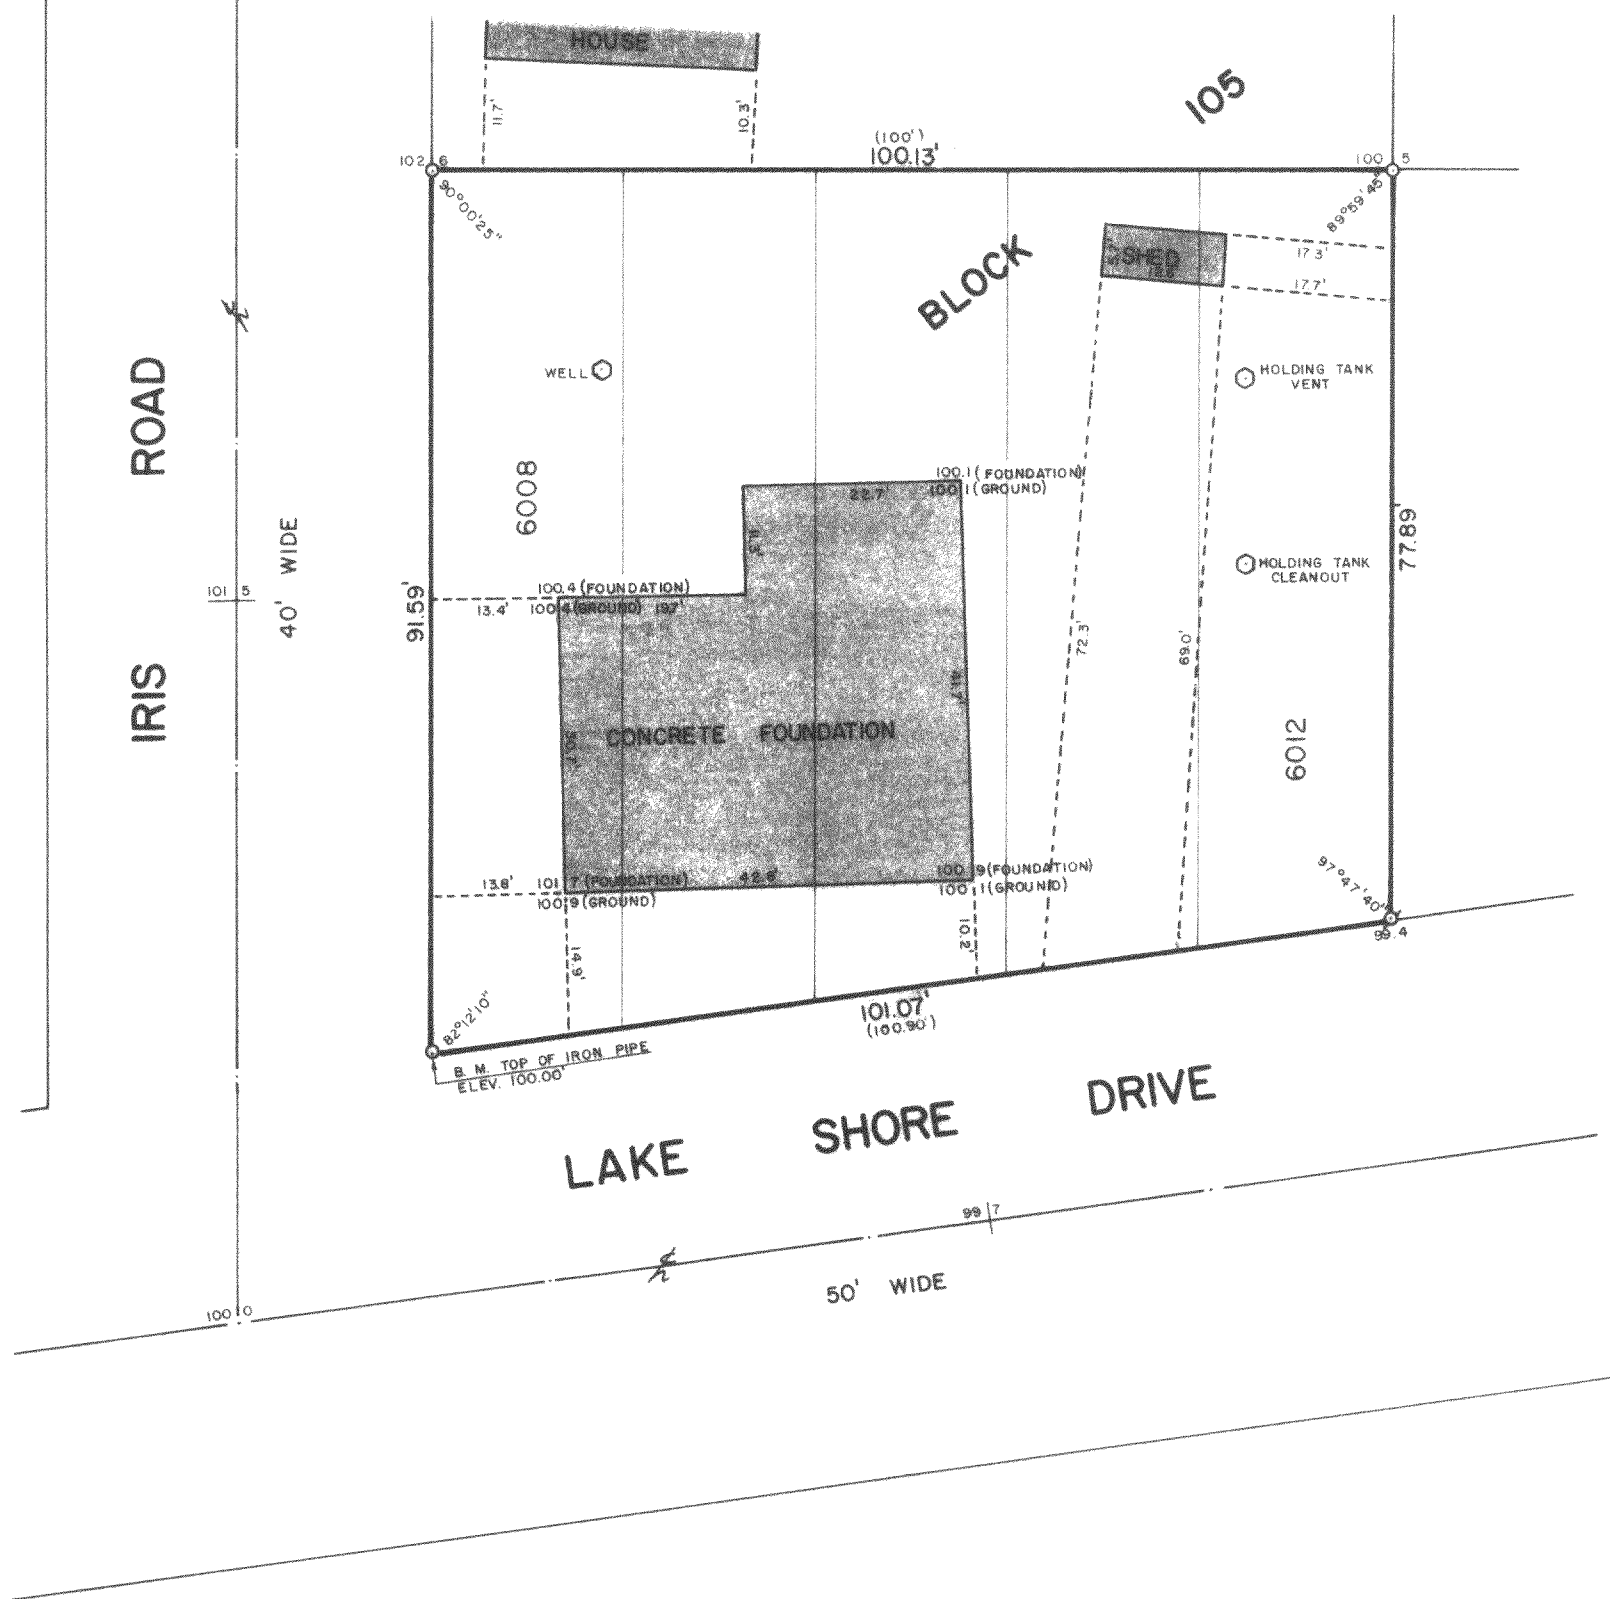


PLAT OF SURVEY OF

LOTS 6008-6012, BLOCK 105, LAKE COMO BEACH,
A SUBDIVISION LOCATED IN T 2 N, R 17 E,
WALWORTH COUNTY, WISCONSIN.


ORDERED BY: DE BELLO CONSTRUCTION
704 CENTER STREET
LAKE GENEVA, WISCONSIN 53147

NOTE: THE MEASUREMENTS SHOWN ON THE CONCRETE
FOUNDATION ARE INSIDE DIMENSIONS.

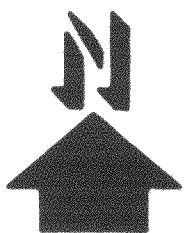

SCALE: 1"=20'

σ - IRON PIPE FOUND
o - IRON PIPE PLACED
() - RECORDED AS

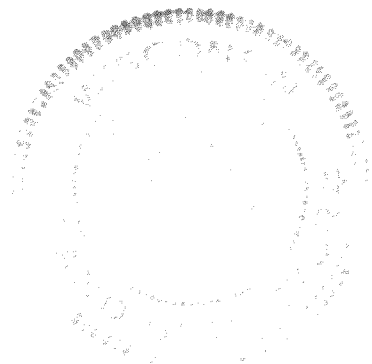

I, HAROLD H. KOLB, DO HEREBY CERTIFY
THAT I HAVE SURVEYED THE PROPERTY
HEREON DESCRIBED ACCORDING TO THE
OFFICIAL RECORDS, AND THAT THE PLAT
HEREON IS A CORRECT REPRESENTATION
OF THE LOT LINES TO THE BEST OF MY
KNOWLEDGE AND BELIEF.

Harold H. Kolb

HAROLD H. KOLB
WISCONSIN REGISTERED LAND SURVEYOR, S-187
DATE Jan 21, 1981