


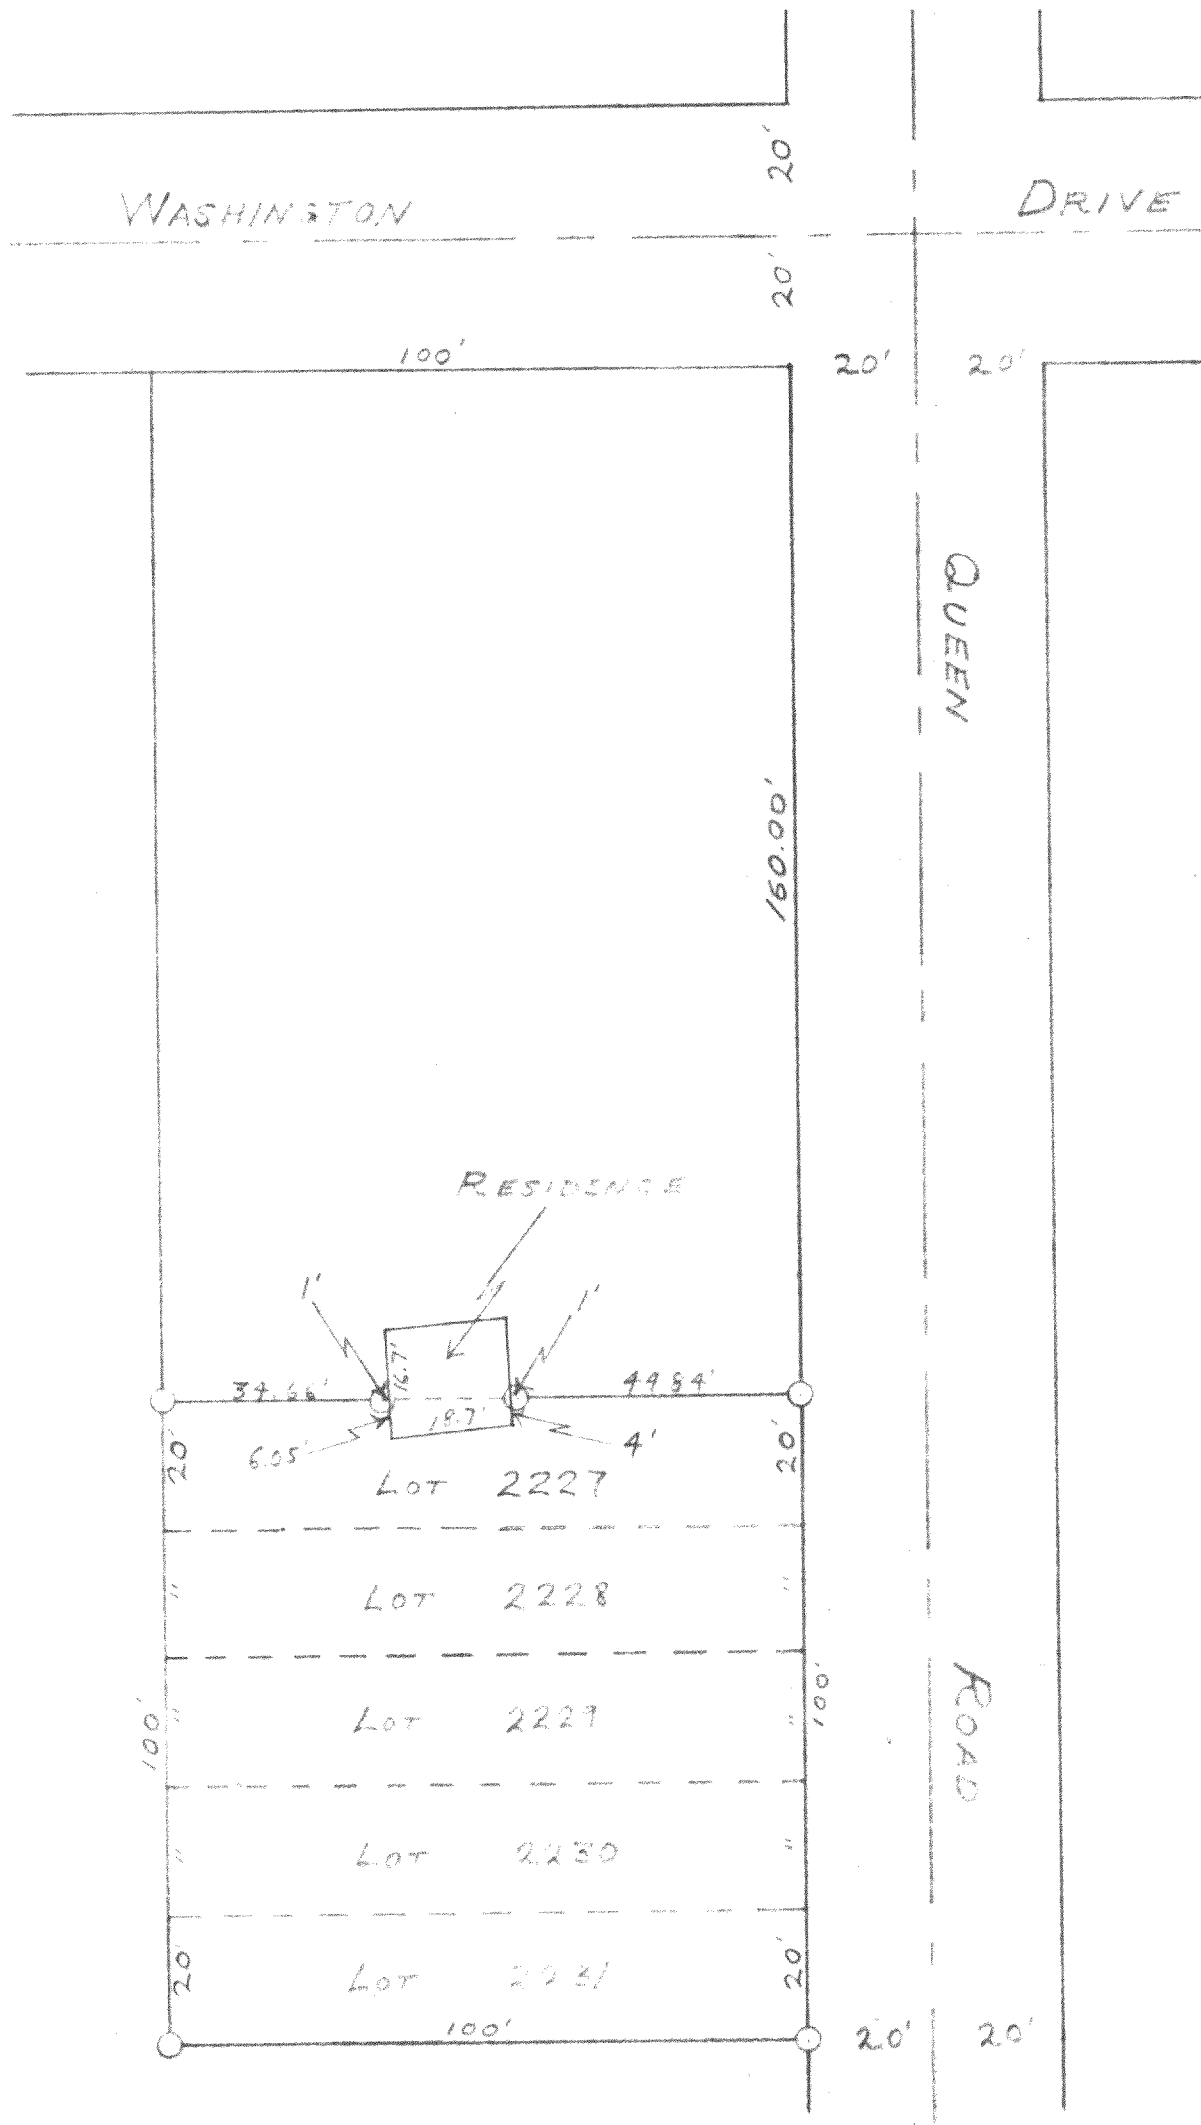

SCALE 1" = 30'
O = IRON STAKE

PLAT OF SURVEY OF LOTS 2227 TO 2231
INCLUDING OF LAKE COMB BEACH SUBDIVISION
WALWORTH COUNTY, WISCONSIN
OCTOBER 2, 1951
JLCB-381

Lloyd S. Jensen
COUNTY SURVEYOR

217-58.1