


Farris, Hansen & Associates, Inc.

ENGINEERING, SURVEYING AND LAND PLANNING
715 W. WALWORTH ST. - P.O. BOX 487 - ELKHORN, WI 53121
OFFICE: 414/723-2088

PLAT OF SURVEY OF LOTS 3706-3708, 3689-3693,
BLOCK 64, LAKE COMD BEACH SUBDIVISION, TOWN 2 NORTH,
RANGE 17 EAST, WALWORTH COUNTY, WISCONSIN.

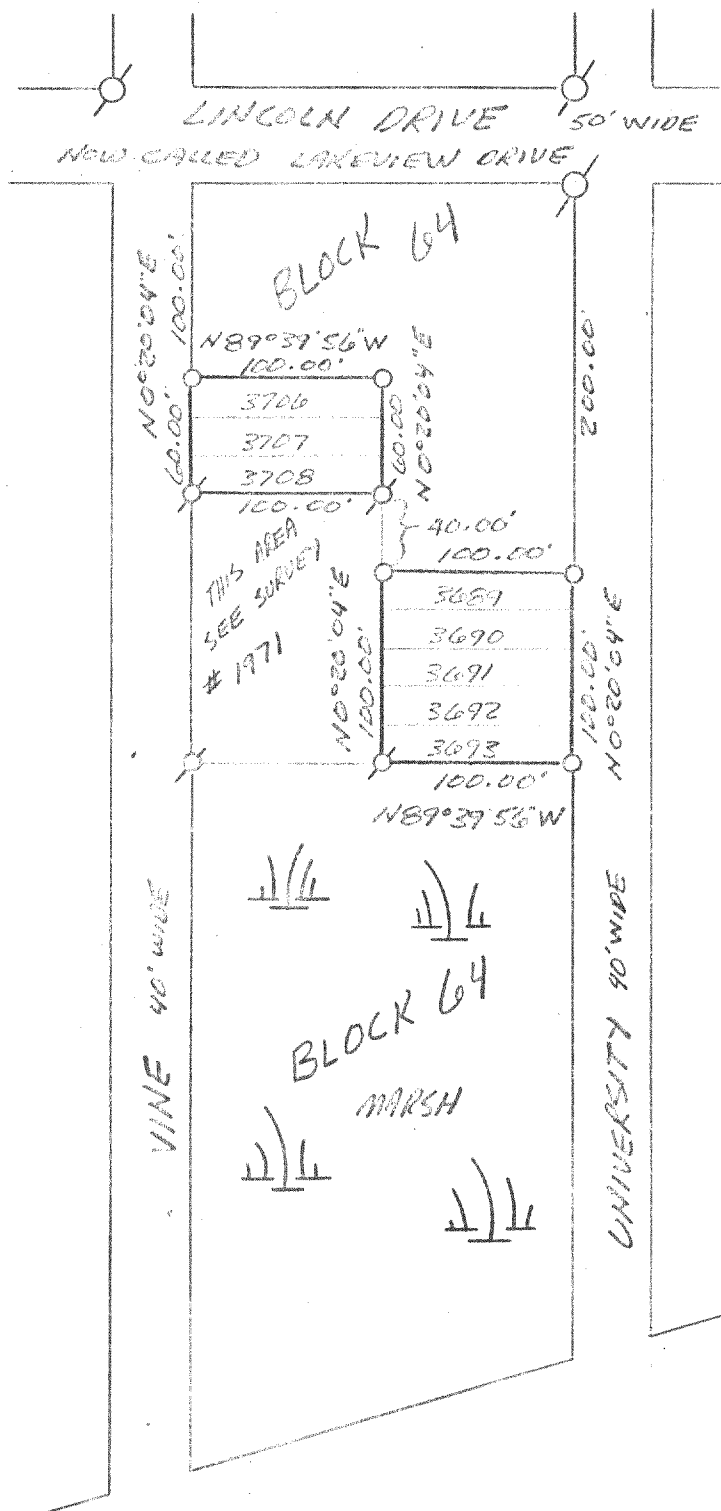

WORK ORDERED BY:
ANKRUT REALTY

SCALE: 1" = 100'
ORIGINAL PLAT BEARINGS


LEGEND

- ⊙ - 2" IRON PIPE FOUND
- ⊘ - 1" IRON PIPE FOUND
- - 1" IRON PIPE SET

I HEREBY CERTIFY THAT I
HAVE SURVEYED THE LANDS
DESCRIBED ABOVE AND THAT
THIS PLAT IS A CORRECT
REPRESENTATION THEREOF TO
THE BEST OF MY PROFESSIONAL
KNOWLEDGE AND BELIEF.

DATED: JULY 30TH, 1982

Robert A. Farris

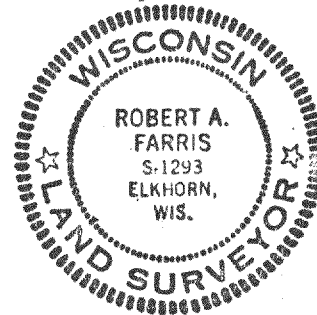

JLCB-699, 696

DRAWING NUMBER 1971-A

217-580 F ✓