


FARRIS, HANSEN & COOPER, INC.

ENGINEERING, SURVEYING AND LAND PLANNING
718 W. WALWORTH ST. - P.O. BOX 487 - ELKHORN, WI 53121
OFFICE: 414/723-2088

217-581F

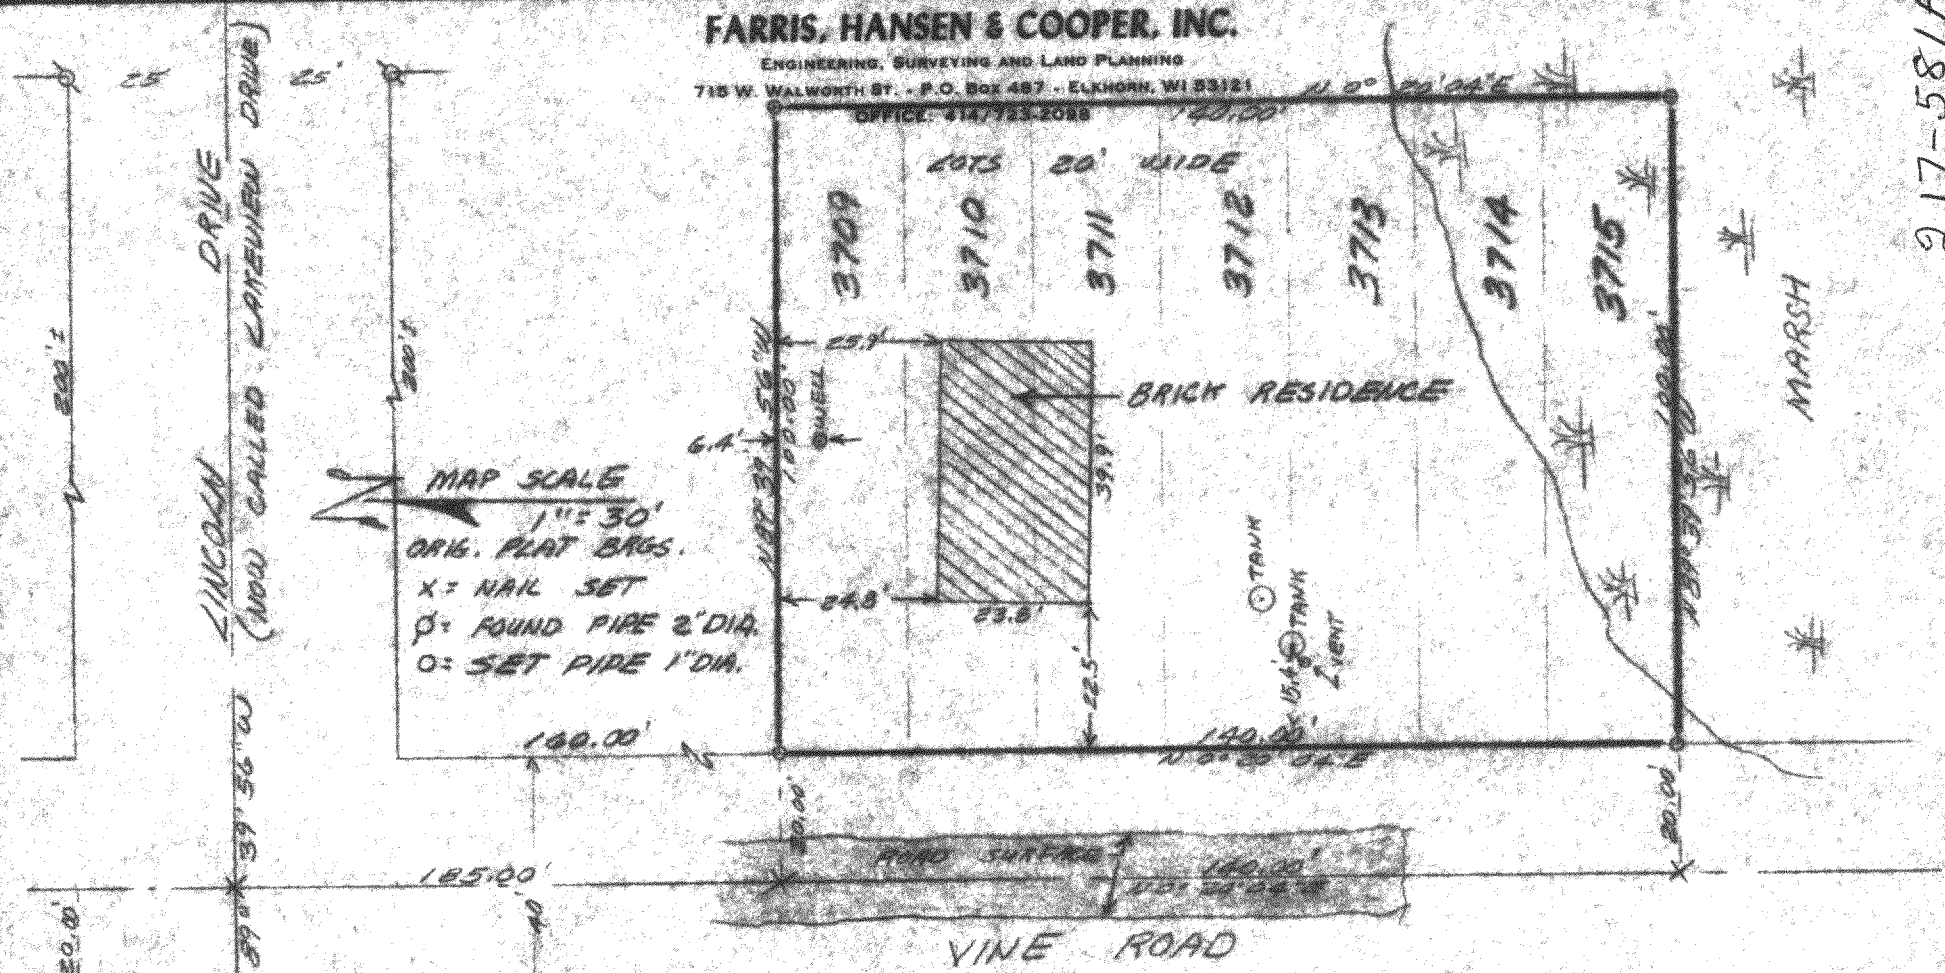


PLAT OF SURVEY OF LOTS 3709-3715, BLOCK 64, LAKE CORD BEACH SUBDIVISION, TOWN 2 NORTH, RANGE 17 EAST, WALWORTH COUNTY, WISCONSIN

WORK ORDERED BY: ANIMANT REALTY
OWNER: JOSEPH LATUSZAK

I HEREBY CERTIFY THAT THIS PLAT IS A TRUE AND ACCURATE REPRESENTATION OF THE LOT LINES AND BUILDING LOCATION TO THE BEST OF MY PROFESSIONAL KNOWLEDGE AND BELIEF.

DATED: 11 JUNE 1982

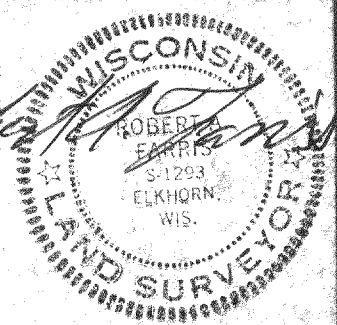

DRAWING NUMBER 1971

JLCB-699