


KOLB LAND CONSULTING, INC.
LAND SURVEYING • SUBDIVIDING • LAND PLANNING

LAKE GENEVA, WISCONSIN 53147


WHITEWATER, WISCONSIN 53190

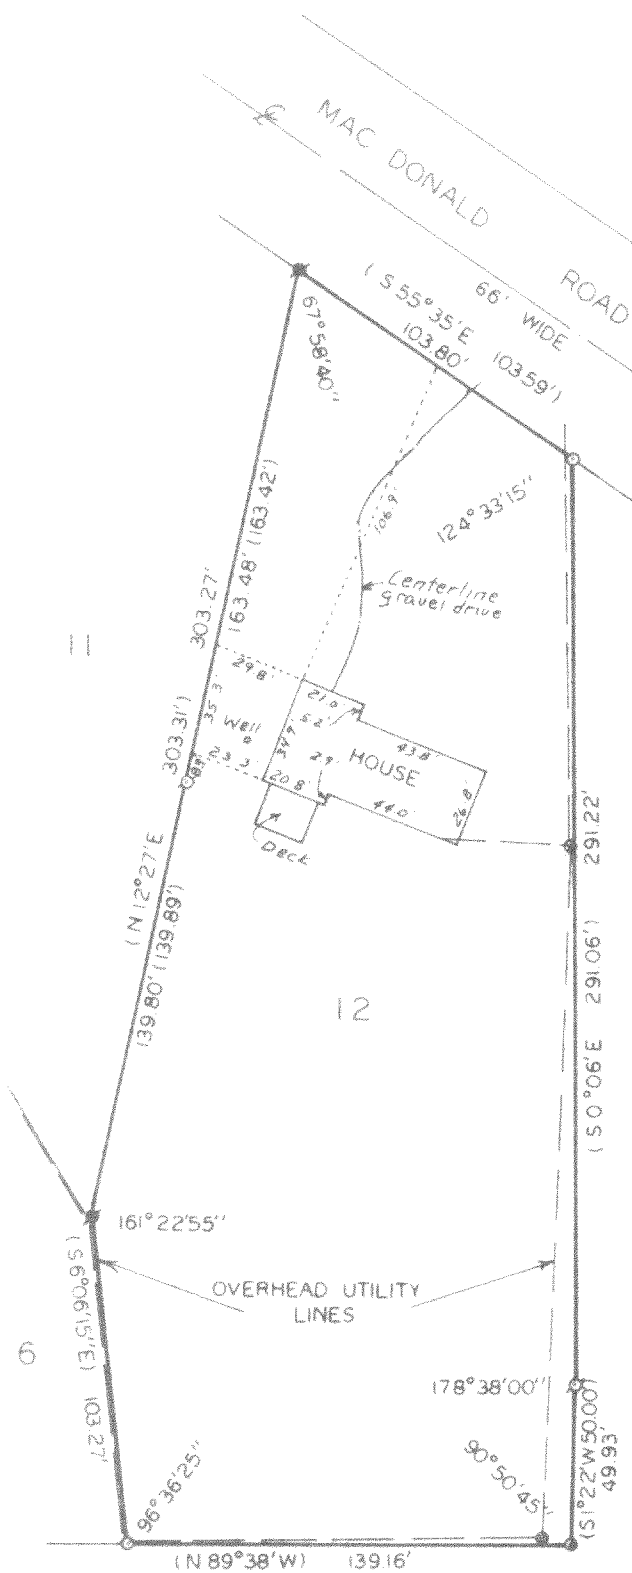

PLAT OF SURVEY OF

LOT 12, INDIAN ECHO ESTATES,
T2N, R17E, WALWORTH COUNTY,
WISCONSIN.

ORDERED BY: STURGE & GAGGART AGENCY
736 MAIN STREET
LAKE GENEVA, WISCONSIN
53147

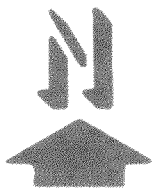

SCALE - 1"=60'

LEGEND

- 12" IRON PIPE FOUND
- 12" IRON PIPE SET
- 12" IRON ROD FOUND
- 12" IRON BAR FOUND
- RECORDED AS
- UTILITY POLE

I HEREBY CERTIFY
THAT I HAVE SURVEYED
THE ABOVE DESCRIBED
PROPERTY AND THAT
THE ABOVE MAP IS A
TRUE REPRESENTATION
THEREOF AND SHOWS
THE SIZE AND LOCATION
OF THE PROPERTY, ITS
EXTERIOR BOUNDARIES, THE
LOCATION OF ALL VISIBLE STRUCTURES AND
OF ALL PRINCIPAL BUILDINGS, FENCES,
BOUNDARY FENCES, APPARENT ENCROACHMENTS,
ROADWAYS AND VISIBLE ENCROACHMENTS, IF
ANY.

THIS SURVEY IS MADE FOR THE USE OF THE
PRESENT OWNERS OF THE PROPERTY, AND ALSO
THOSE WHO PURCHASE, MORTGAGE, OR
GUARANTEE THE TITLE THERETO WITHIN ONE
(1) YEAR FROM DATE HEREOF.

HAROLD H. KOLB
WISCONSIN REGISTERED LAND SURVEYOR, S-187
DATE Jan. 20, 1982

217-581-K✓