


Farris, Hansen & Associates, Inc.

ENGINEERING, SURVEYING AND LAND PLANNING
715 W. WALWORTH ST. - P.O. BOX 487 - ELKHORN, WI 53121

OFFICE: 414/723-2088

PLAT OF SURVEY OF LOTS 6125-6132, 6099-6107, BLOCK
107, LAKE LAND BEACH SUBDIVISION, TOWN 2 NORTH,
RANGE 17 EAST, WALWORTH COUNTY, WISCONSIN.

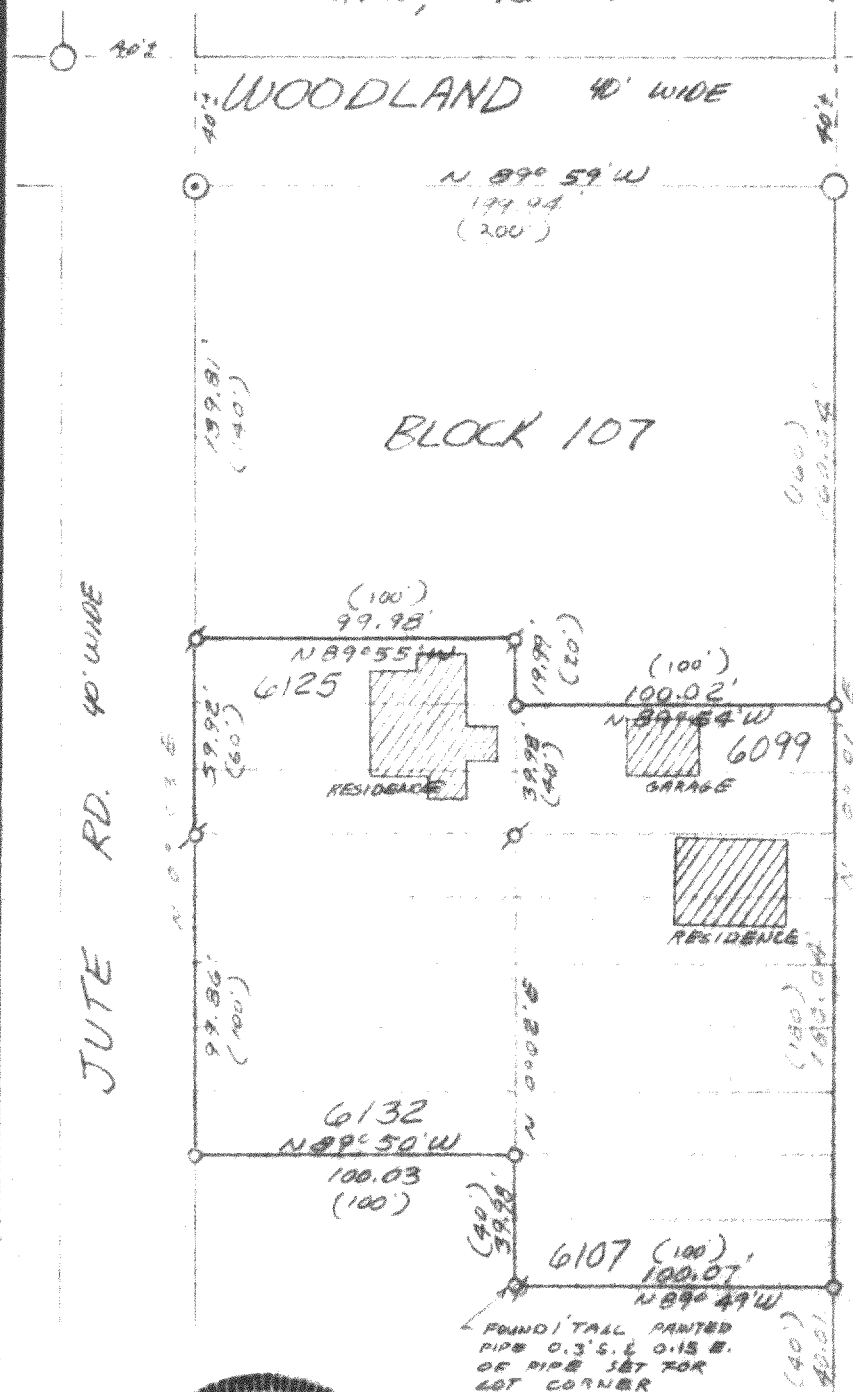

WORK ORDERED BY:
MIKROT REALTY

LEGEND

- - 1 3/4" IRON PIPE FOUND
- ⊙ - 1 1/2" IRON PIPE FOUND
- - 1" IRON PIPE SET
- ⊗ - 1" IRON PIPE FOUND

SCALE: 1" = 60'


(XXX) = RECORD DIMENSION

I HEREBY CERTIFY
THAT I HAVE SURVEYED
THE LANDS DESCRIBED
ABOVE AND THAT THIS
PLAT IS A CORRECT
REPRESENTATION THERE-
OF TO THE BEST OF
MY PROFESSIONAL
KNOWLEDGE AND
BELIEF.

DATED:

AUGUST 5TH, 1982

Robert A. Farris

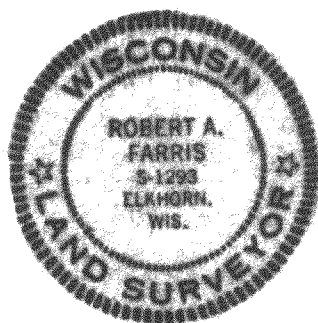

N.E. COR. BLOCK 108

DRAWING NUMBER 1982