
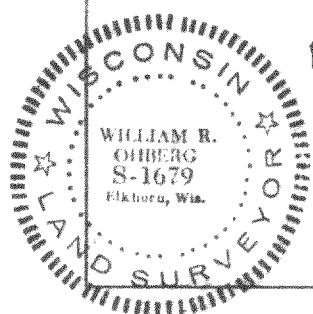


Farris, Hansen & Associates, Inc.

Engineering, Surveying & Land Planning
P.O. BOX 487
715 W. WALWORTH STREET
ELKHORN, WISCONSIN 53121

PLAT OF SURVEY OF

LOTS 4890-4893, BLOCK 86, LAKE COMO BEACH
SUBDIVISION, TOWN OF GENEVA, WALWORTH CO., WIS.

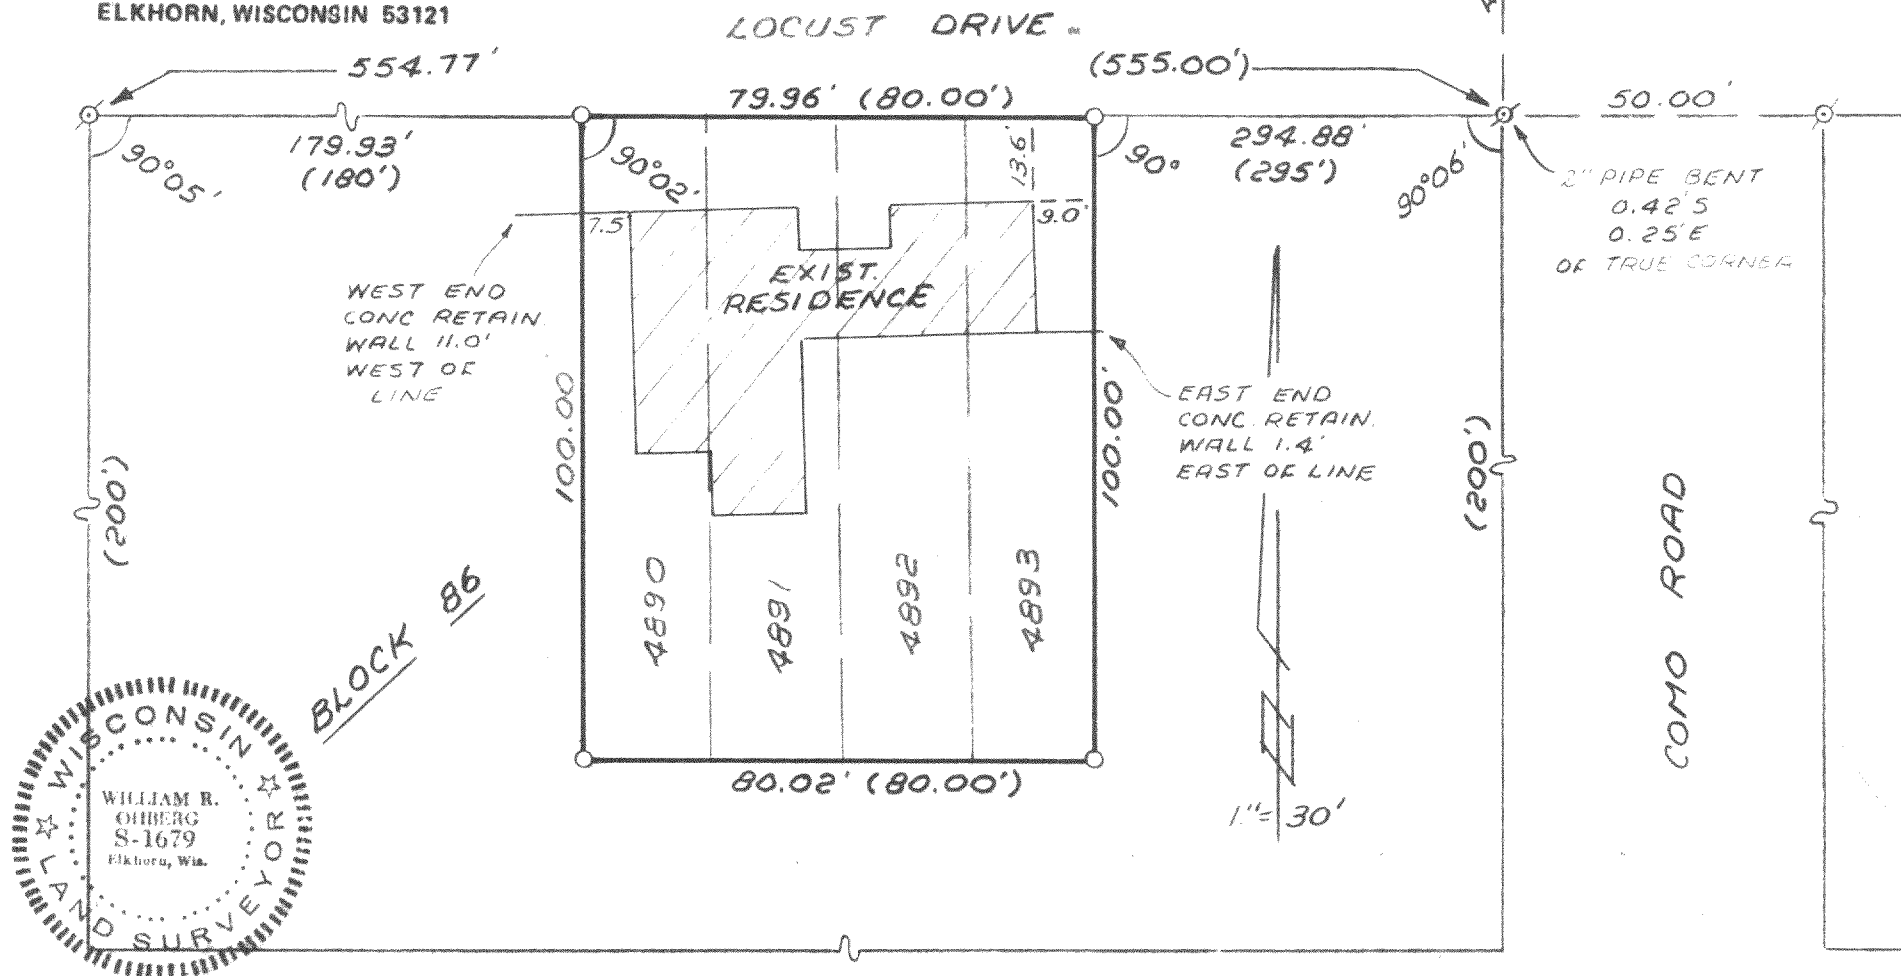

I HEREBY CERTIFY that I have surveyed the above described property and that this plat is a correct representation thereof.

William R. Ohberg
WILLIAM R. OHBERG, RLS

MAGNOLIA DRIVE

Dated this 7TH day of APRIL, 1983.

- () — Record Dimension
- — 1" Dia. Iron Pipe Set
- ⊗ — 2" Orig. Iron Pipe Found

WORK ORDERED BY: MODERN REALTY

50.00'

PROJECT NO. 2084