

FARRIS, HANSEN & COOPER, INC.


ENGINEERING, SURVEYING AND LAND PLANNING
718 W. WALWORTH ST. - P.O. BOX 487 - ELKHORN, WI 53121
OFFICE: 414/733-2088

N



MAP SCALE
1"=30'


- Ø -2" Dia. Iron Pipe Found
- Ø -1" Dia. Iron Pipe Found
- -1"x 24" Iron Pipe Set
- () -Record Dimension

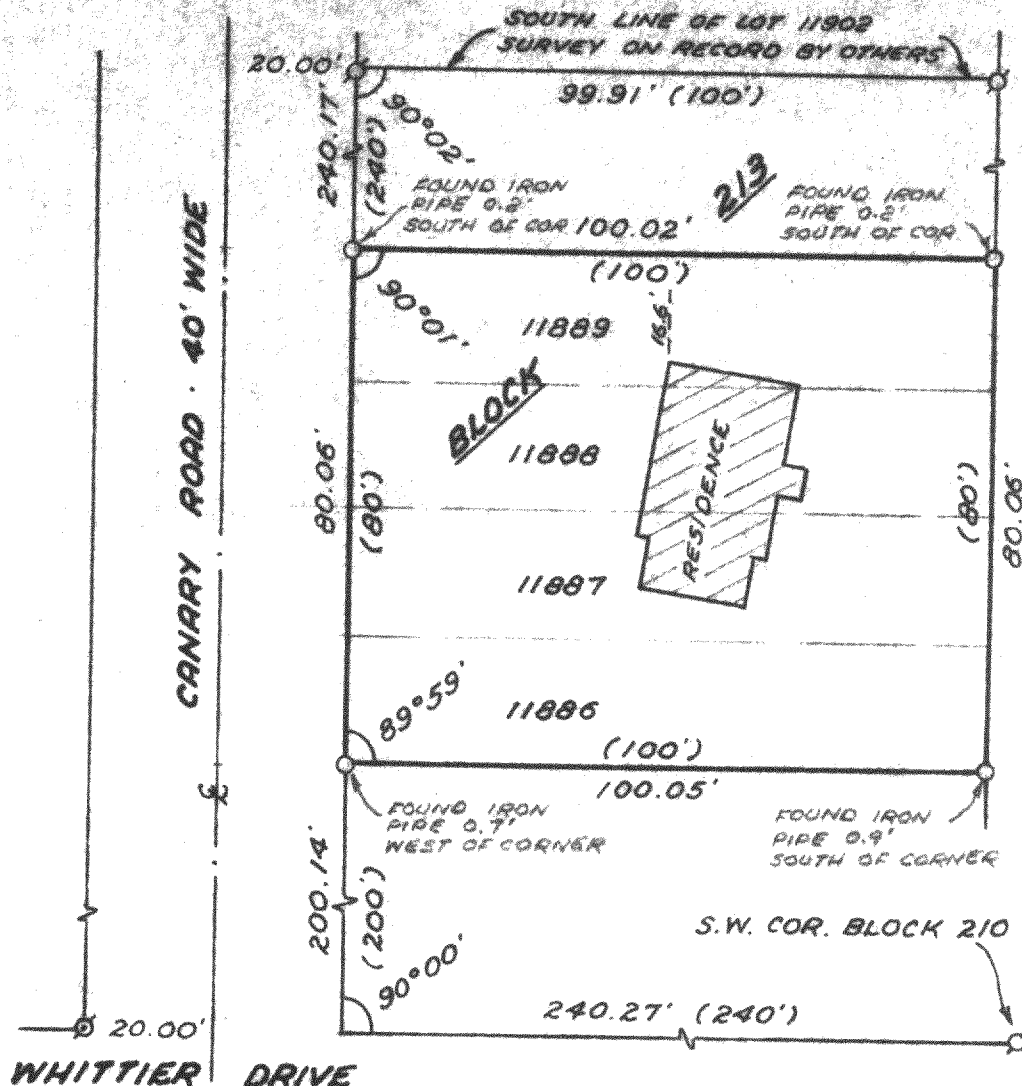

PLAT OF SURVEY OF

LOTS 11886-11889, BLOCK 213, LAKE COMO BEACH SUBDIVISION, TOWN 2 NORTH, RANGE 17 EAST, WALWORTH COUNTY, WISCONSIN.

I hereby certify that at the request of Casey Mikrut I have surveyed lots 11886-11889 of Lake Como Beach Sub. in the Town of Geneva, Walworth Co., Wis and that this Plat of Survey is a true and accurate representation of the lot lines and buildings located on said property to the best of my professional knowledge and belief.

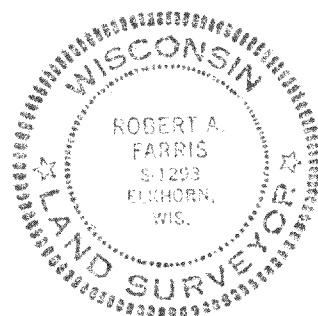

Robert A. Farris
Robert A. Farris, RLS No. 1293
Dated this 12th day of October 1982.

JLCB-2587

DRAWING NUMBER 2014

217-584-EF