
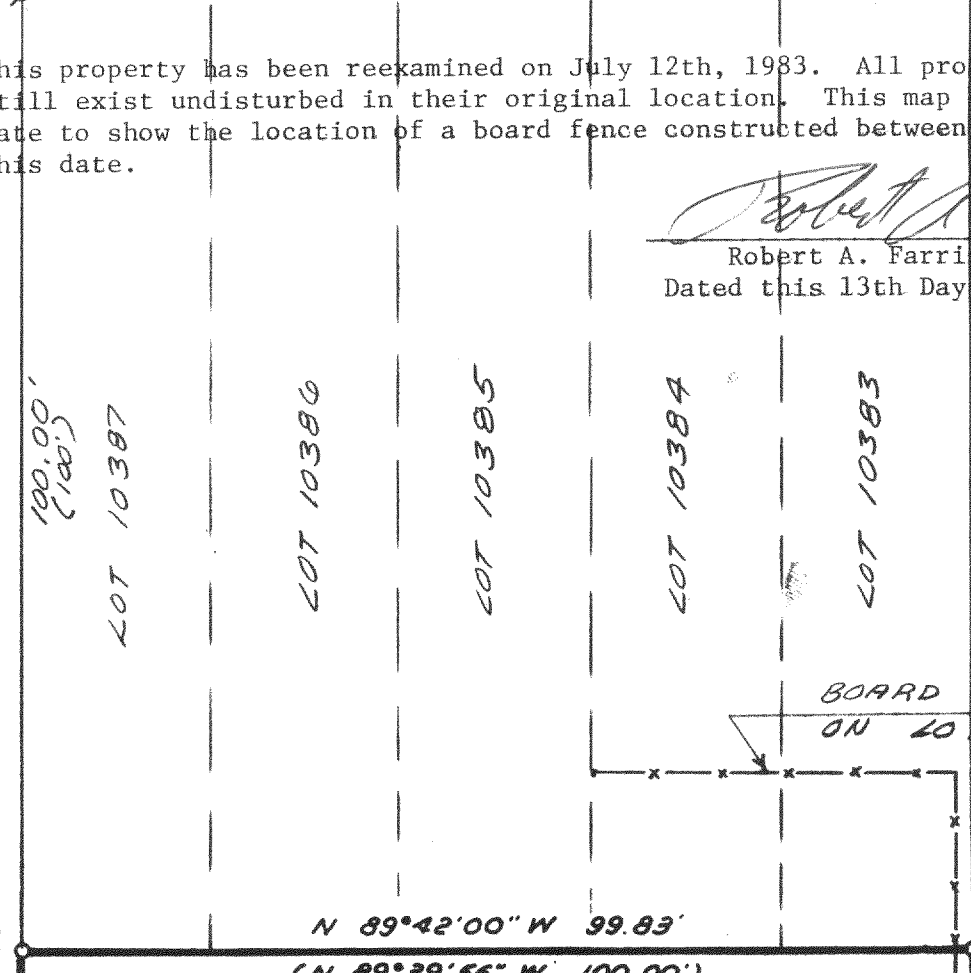



NW BLOCK COR. WHITTIER DRIVE NE BLOCK COR.
N 89°41'19"W 199.66' (200')

This property has been reexamined on July 12th, 1983. All property corners indicated still exist undisturbed in their original location. This map has been revised this date to show the location of a board fence constructed between Jan. 27, 1982 and this date.

Robert A. Farris
Robert A. Farris RLS
Dated this 13th Day of July 1983

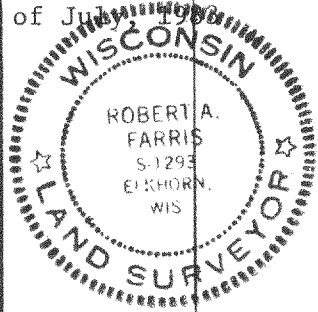


BOARD FENCE ENCROACHES
ON LOTS 10383 & 10384

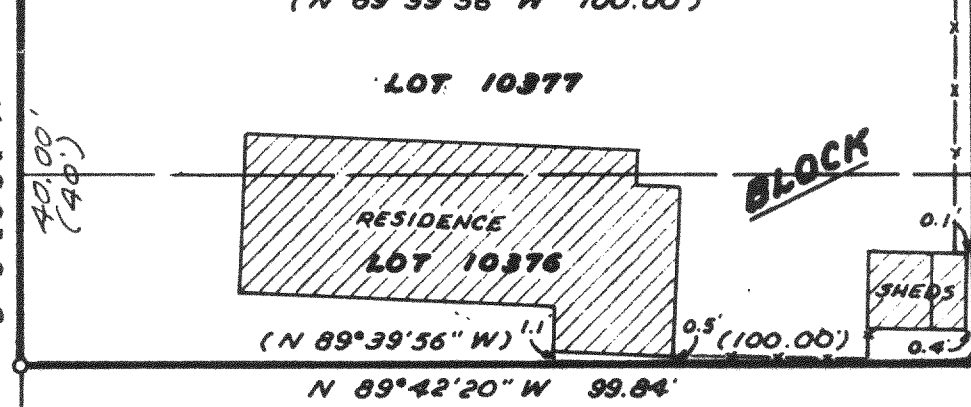

N 89°42'00" W 99.83'
(N 89°39'56" W 100.00')

LOT 10377

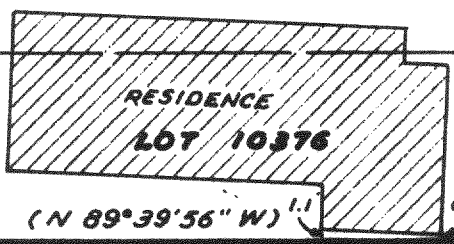

(N 89°39'56" W) 100.00'

N 89°42'20" W 99.84'

PLAT OF SURVEY OF

LOTS 10377 AND 10376, BLOCK 188, LAKE COMO BEACH
SUBDIVISION, SECTION 28, TOWN 2 NORTH, RANGE 17 EAST,
WALWORTH COUNTY, WISCONSIN.

LEGEND

- Ø—2" Iron Pipe Found
- 1" Iron Pipe Set
- ()—Record Dimension
- x—x—x— BOARD FENCE


ORDERED BY:

Mikrut Realty

(N 62°13'13"E)
(N 62°07'25"E)
SHORE DRIVE

NOTE: The West line of Block 188 is assumed to bear S 0°20'04" W as shown on Original Plat.

SCALE: 1"=40'

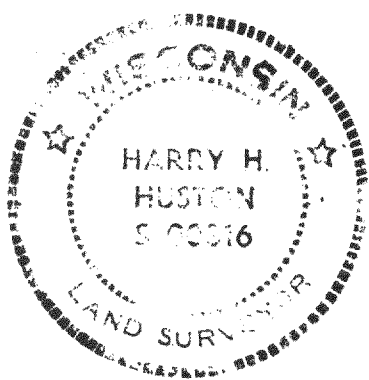

I HEREBY CERTIFY that the property described hereon has been surveyed under my direction and that this Plat of Survey is a true and accurate representation of the lot lines to the best of my professional knowledge and belief.

Harry H. Huston
Harry H. Huston, RLS No. 00316

Dated this 27th day of JAN., 1982.

FARRIS, HANSEN & ASSOCIATES, INC.
715 W. Walworth St. P.O. Box 487
Elkhorn, WI 53121

DRAWING NUMBER 1926

JLGB-2247

217-585-F