


PLAT OF SURVEY OF LOTS 6225, 6226, 6227, 6228, & 6229 OF BLOCK 108, OF LAKE COMO BEACH,
A SUBDIVISION LOCATED IN TOWN 2 NORTH, RANGE 17 EAST, WALWORTH COUNTY, WISCONSIN

Jute Road


40' WIDE

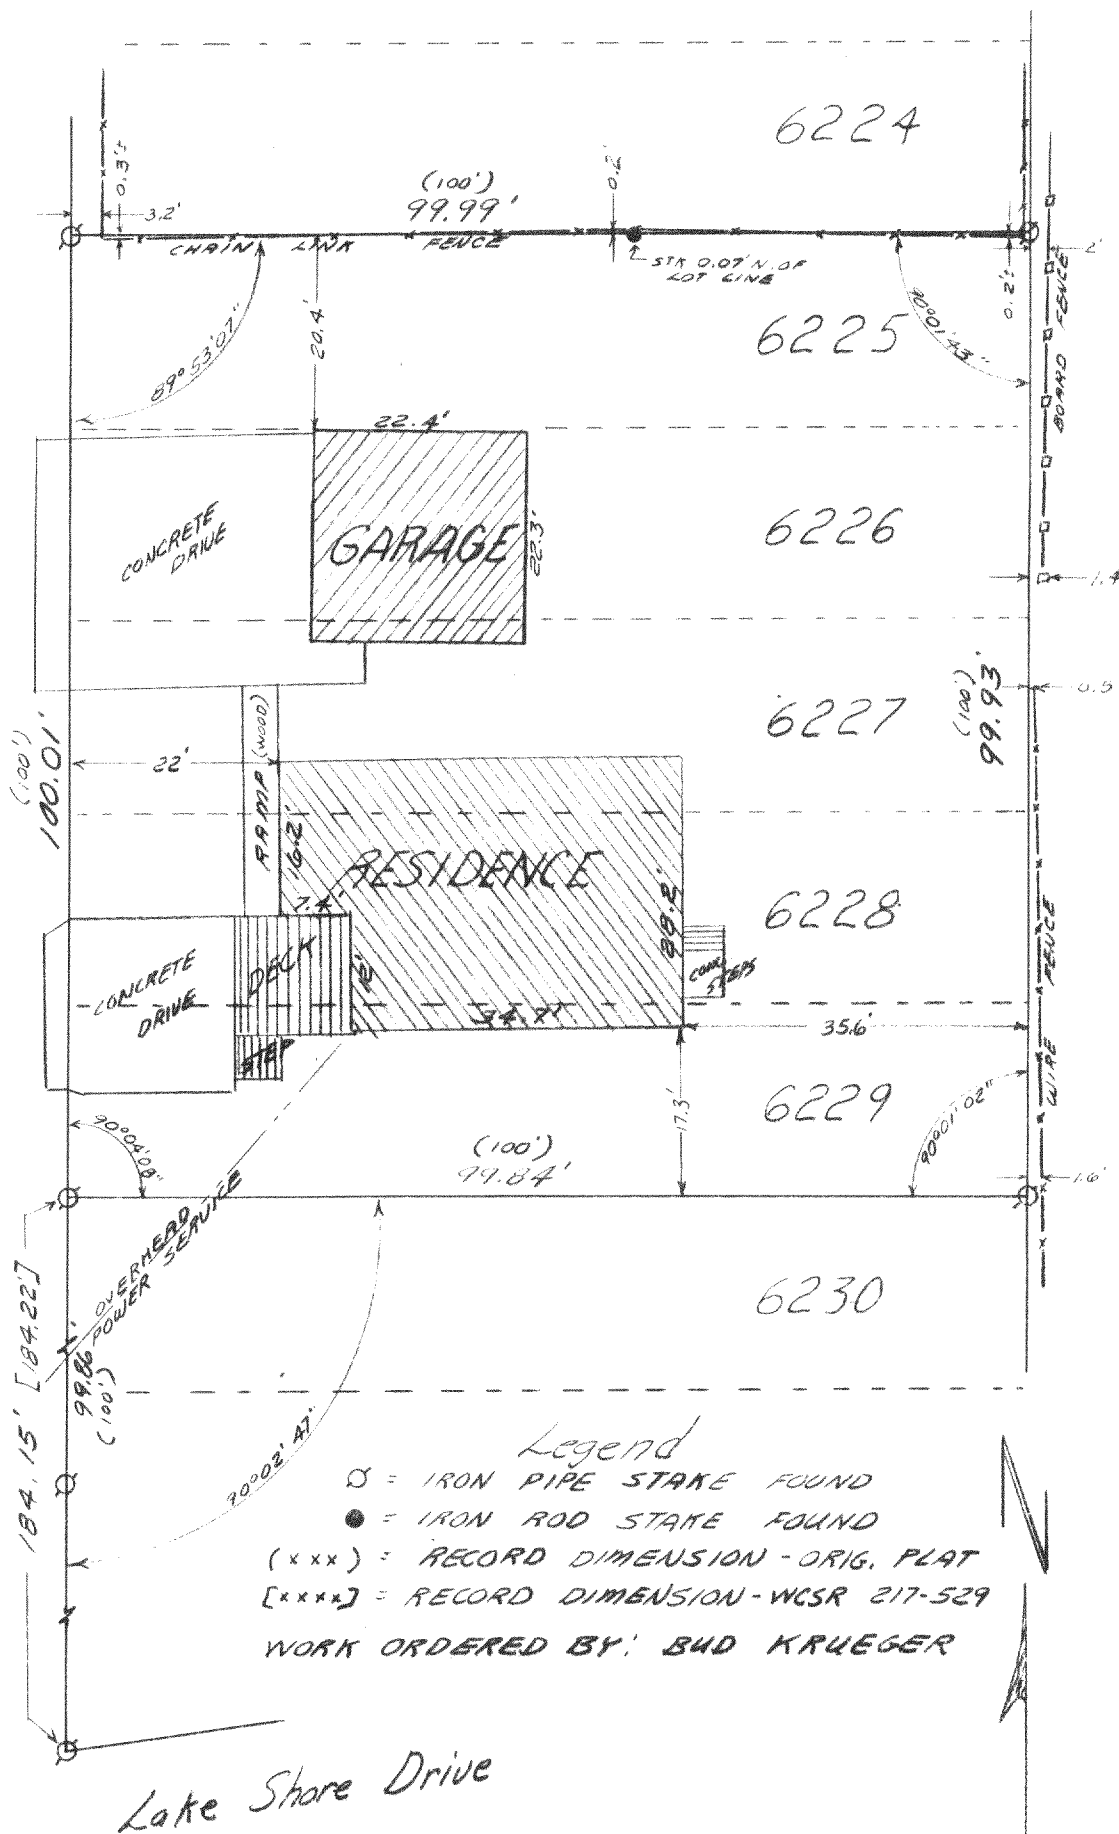

Lake Shore Drive

I hereby certify that I have surveyed the above described property and that the above map is a true representation thereof and shows the size and location of the property, its exterior boundaries, the location of all visible structures and dimensions of all principal buildings thereon, boundary fences, apparent easements, roadways and visible encroachments, if any.

This survey is made for the use of the present owners of the property, and also those who purchase, mortgage, or guarantee the title thereto within one (1) year from date hereof.

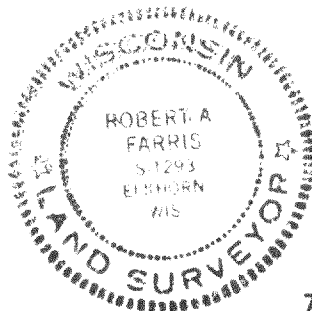

MAP SCALE
1" = 20'

FARRIS, HANSEN & ASSOCIATES, INC.
715 W. Walworth St. P.O. Box 487
Elkhorn, WI 53121

Robert A. Farris

23 Aug. 1983

PROJ. # 2150

217-586-F ✓

JLCB-1289