


WALWORTH COUNTY
SURVEYING & MAPPING
LAKE GENEVA, WISCONSIN

RECEIVED
JUL 3 1985

OAK ROAD

40' WIDE

(220')
220.12'

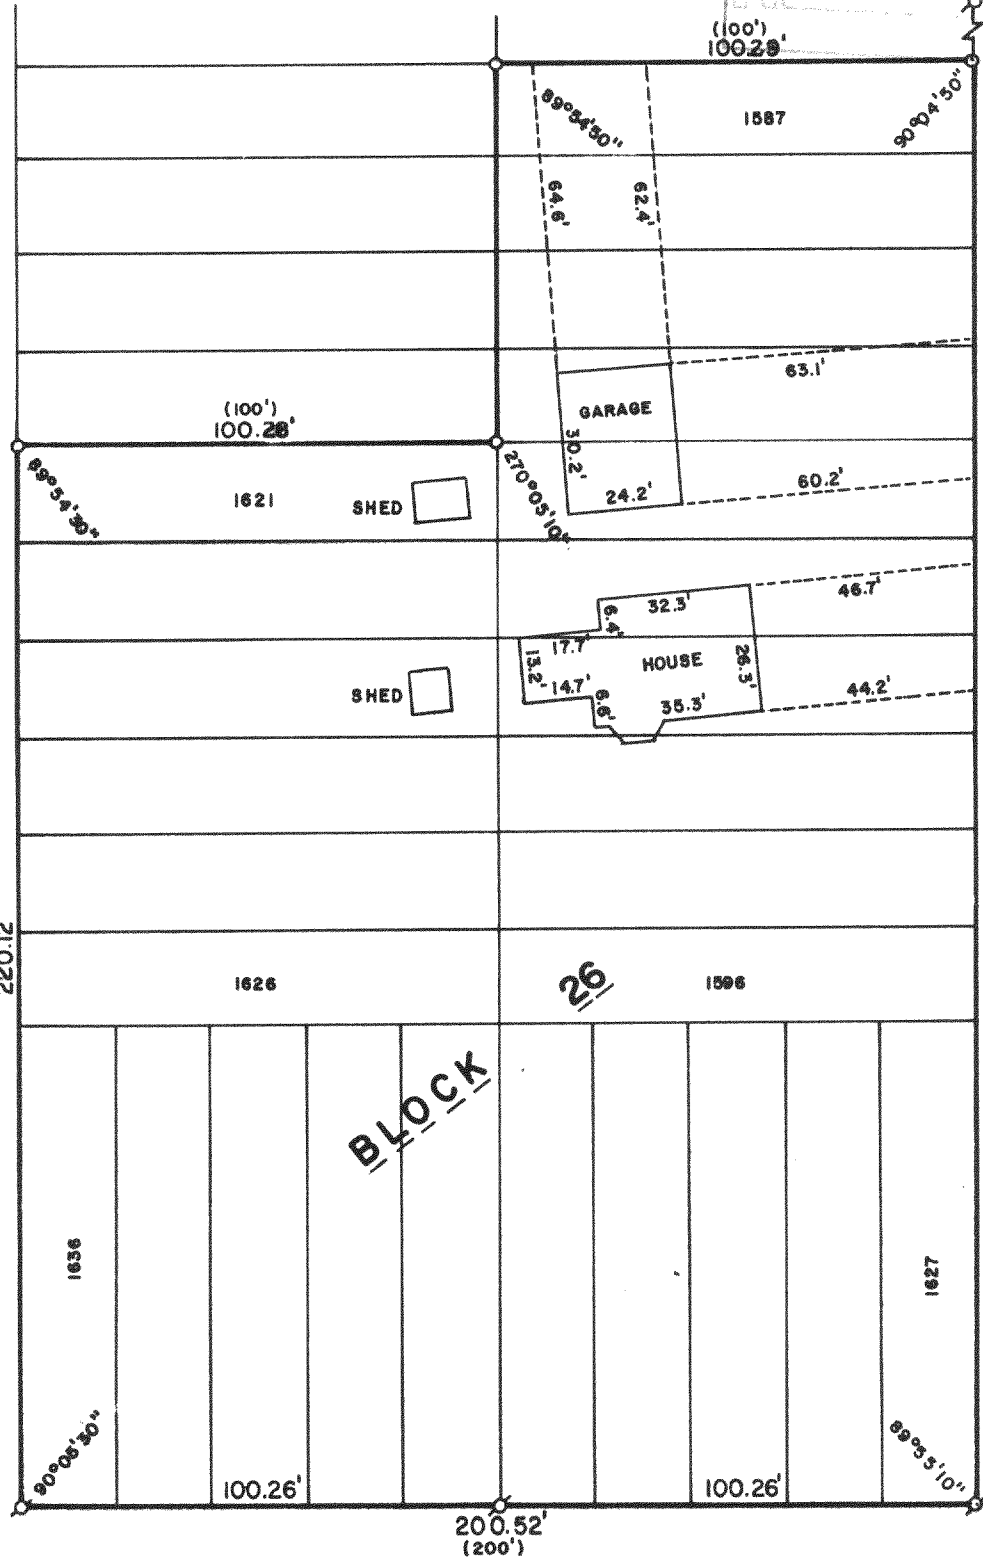

NARCISSUS ROAD

40' WIDE

300.16'
(300')

(WOODLAND DRIVE)

40' WIDE

PLAT OF SURVEY OF



LOTS 1587-1596 AND 1621-1636, BLOCK 26 OF
LAKE COMO BEACH SUBDIVISION, T 2 N, R 17 E,
WALWORTH COUNTY, WISCONSIN.

ORDERED BY: MIKRUT REALTY
RT. 5, BOX 453
LAKE GENEVA, WISCONSIN 53147

I, ROBERT M. BAERENWALD, DO HEREBY CERTIFY THAT I
HAVE SURVEYED THE PROPERTY HEREON DESCRIBED ACCORDING
TO THE OFFICIAL RECORDS AND THAT THE PLAT HEREON IS A
CORRECT REPRESENTATION OF THE PROPERTY LINES TO THE
BEST OF MY KNOWLEDGE AND BELIEF.

Robert M. Baerenwald
ROBERT M. BAERENWALD
WISCONSIN REGISTERED LAND SURVEYOR, 3-1508

Dec. 10, 1984
DATE JOB NO. 0160

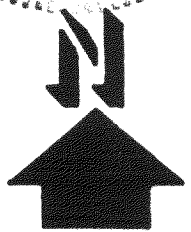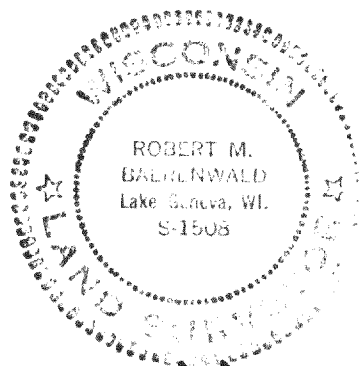

SCALE: 1"=40'
σ-IRON PIPE FOUND
○-IRON PIPE PLACED
()-RECORDED AS