


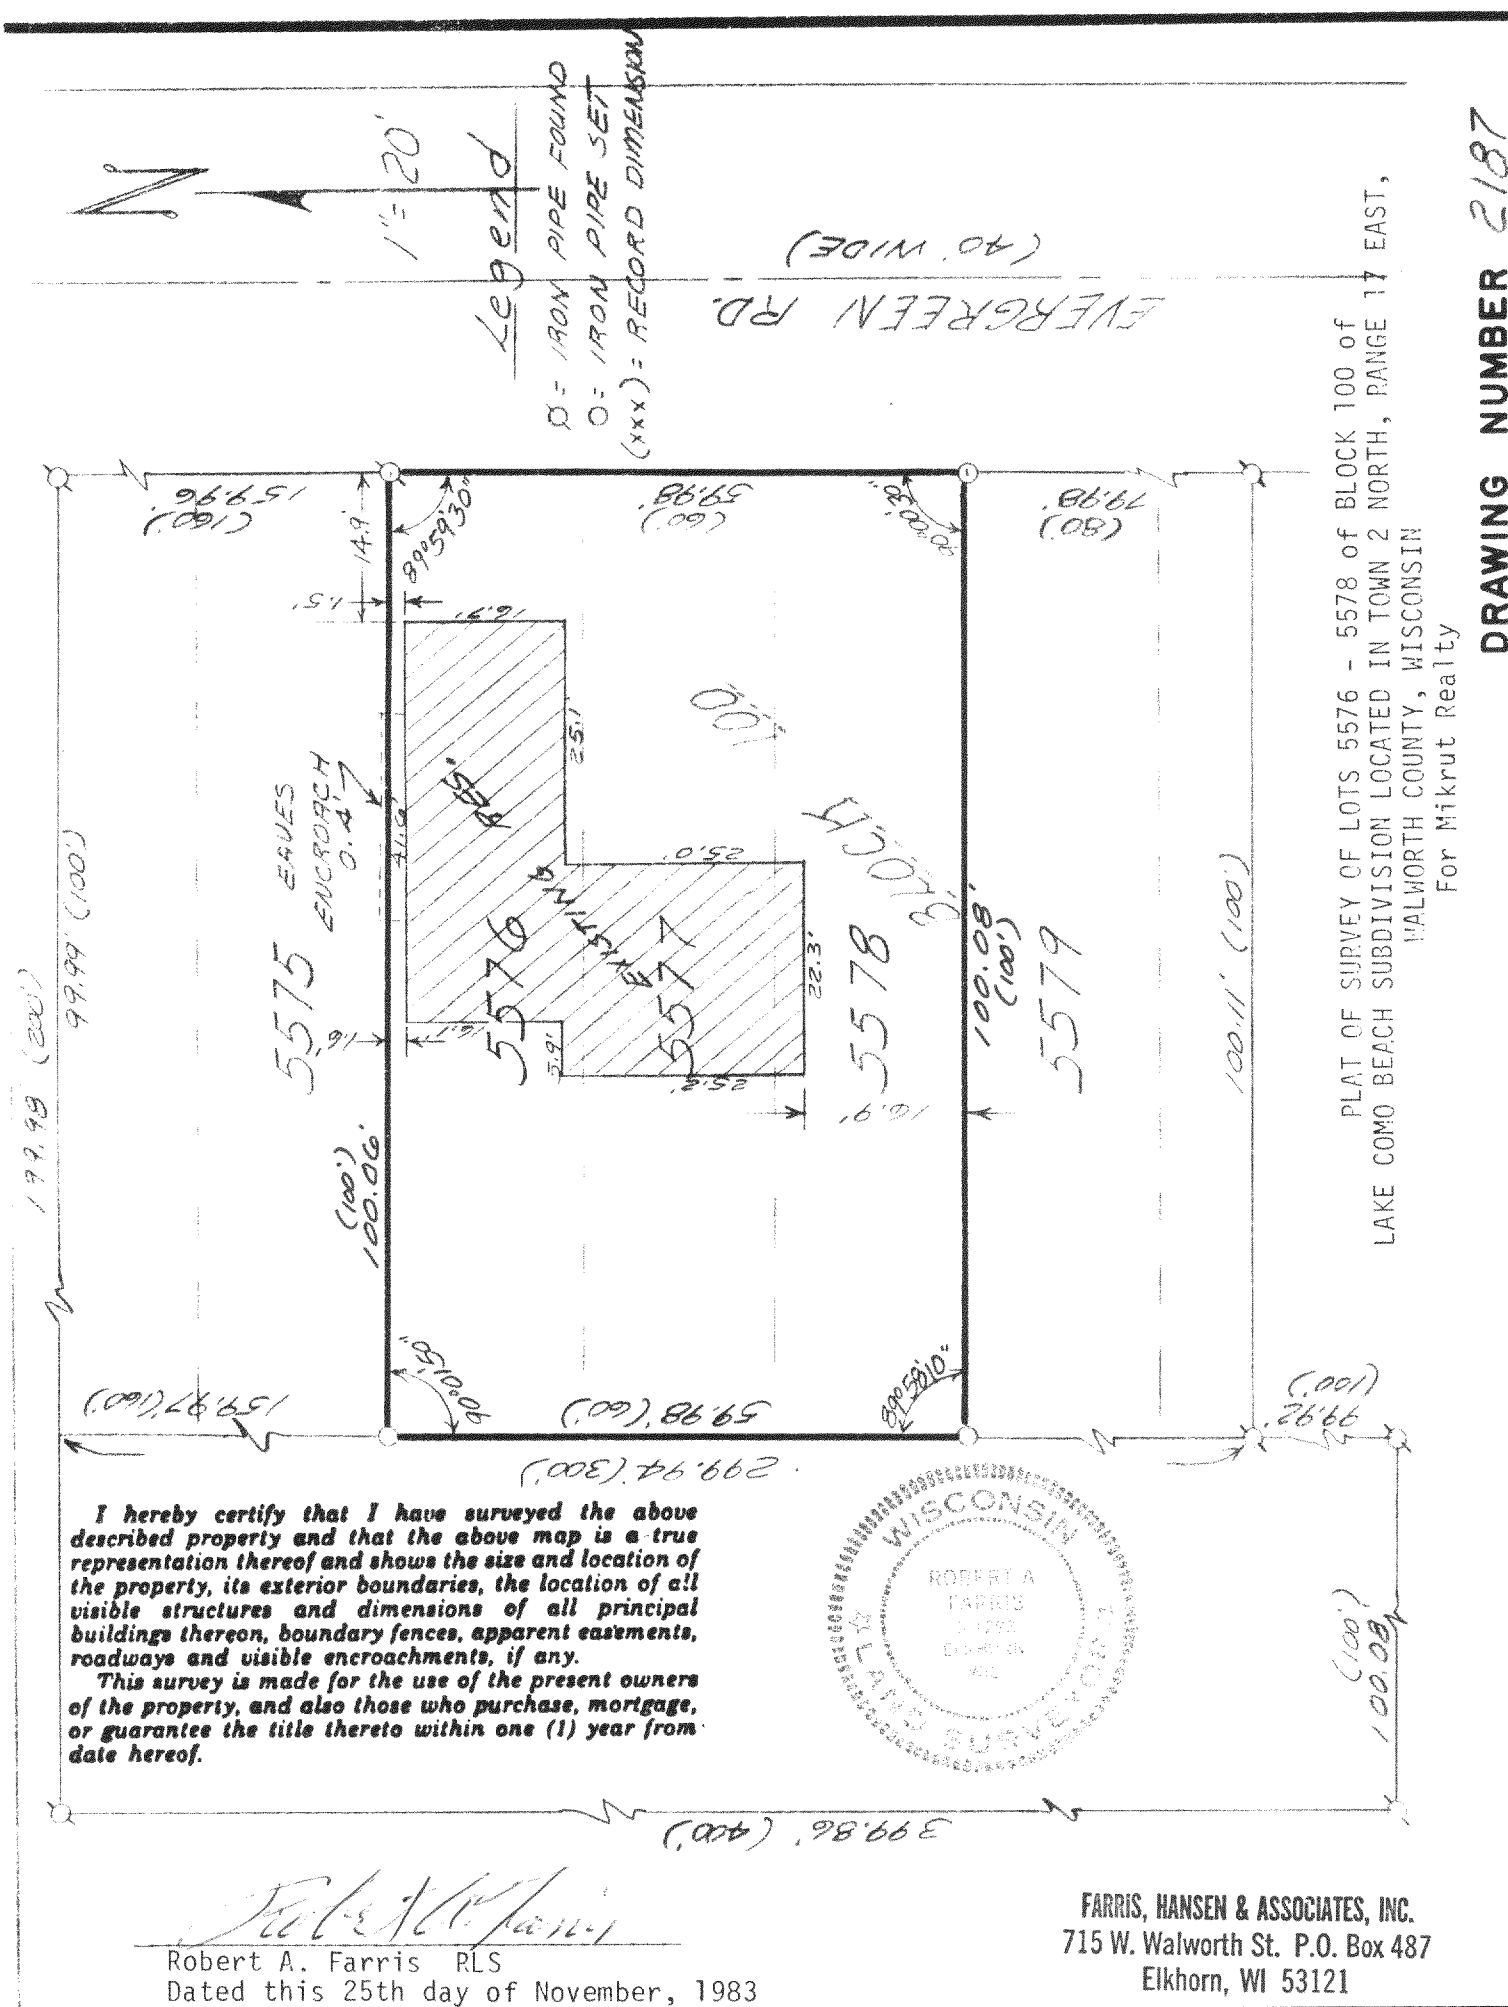

JL 8-1134

217-588-F