
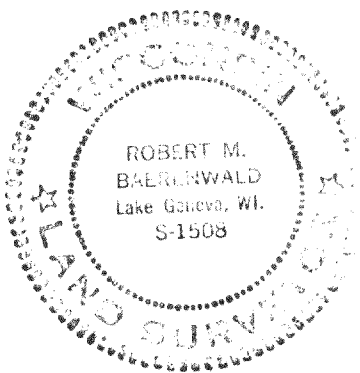



WALWORTH COUNTY
SURVEYING & MAPPING
LAKE GENEVA, WISCONSIN

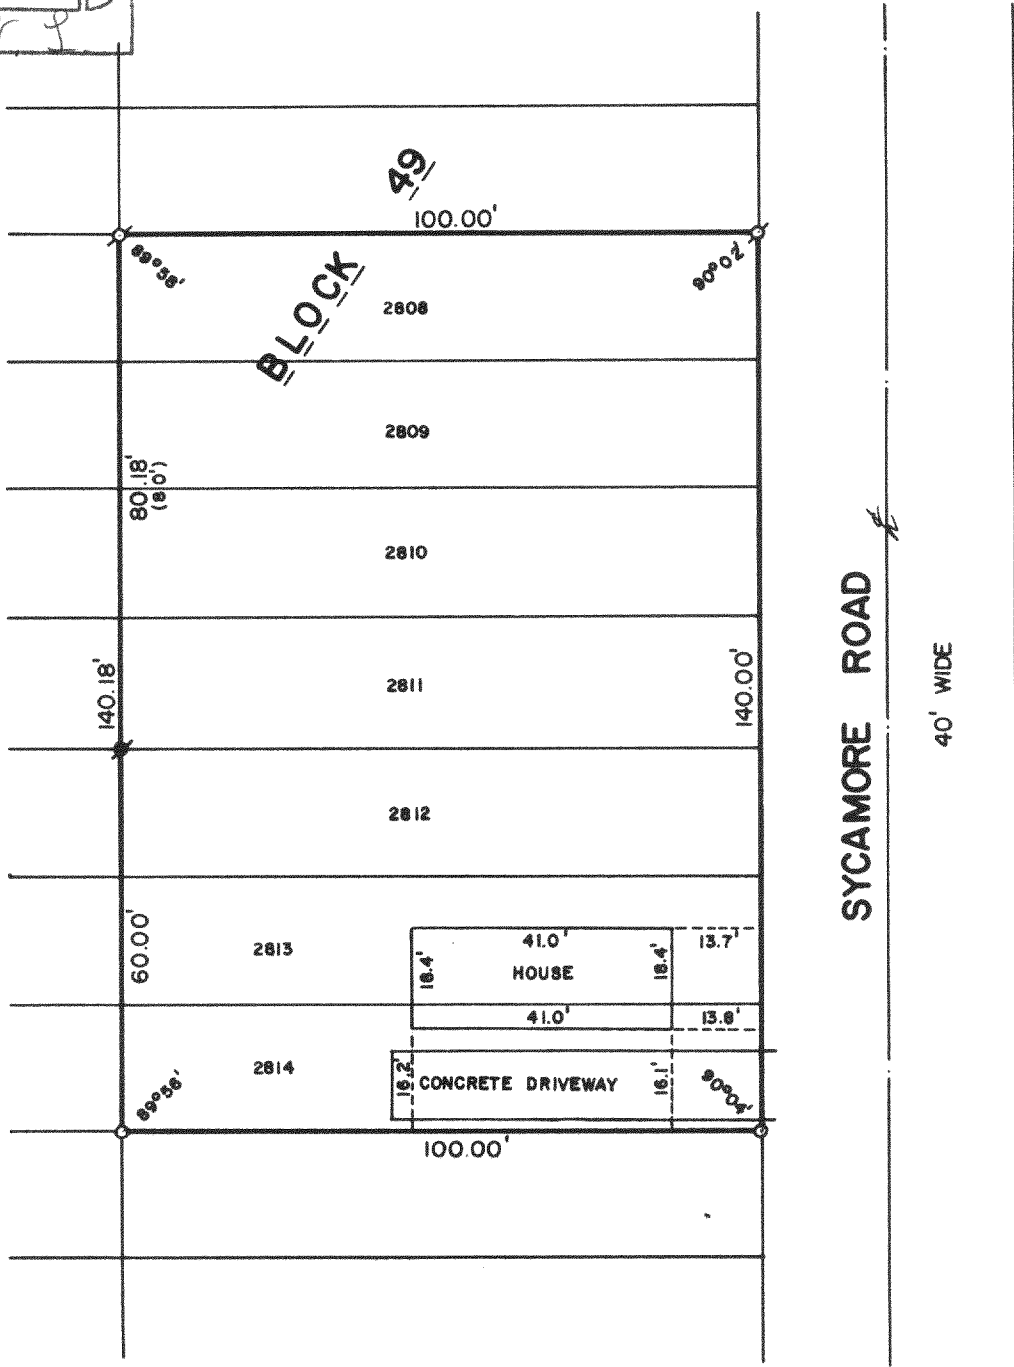

PLAT OF SURVEY OF

LOTS 2808-2814, BLOCK 49 OF LAKE COMO BEACH
SUBDIVISION, T 2 N, R 17 E, WALWORTH COUNTY,
WISCONSIN.

ORDERED BY: 1ST BANK SOUTHEAST
303 CENTER STREET
LAKE GENEVA, WISCONSIN 53147

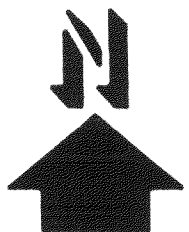

SCALE: 1"=30'

- ⊙-IRON PIPE FOUND
- IRON PIPE PLACED
- CONCRETE MONUMENT FOUND
- ()-RECORDED AS

I, ROBERT M. BAERENWALD, DO HEREBY CERTIFY THAT I
HAVE SURVEYED THE PROPERTY HEREON DESCRIBED ACCORDING
TO THE OFFICIAL RECORDS AND THAT THE PLAT HEREON IS A
CORRECT REPRESENTATION OF THE PROPERTY LINES TO THE
BEST OF MY KNOWLEDGE AND BELIEF.

Robert M. Baerenwald
ROBERT M. BAERENWALD
WISCONSIN REGISTERED LAND SURVEYOR, S-1508

Dec. 30, 1984
DATE JOB NO. 0178

JLCB-492

217-589-13