


KOLB LAND CONSULTING, INC.  
LAND SURVEYING • SUBDIVIDING • LAND PLANNING

LAKE GENEVA, WISCONSIN 53147


WHITEWATER, WISCONSIN 53190

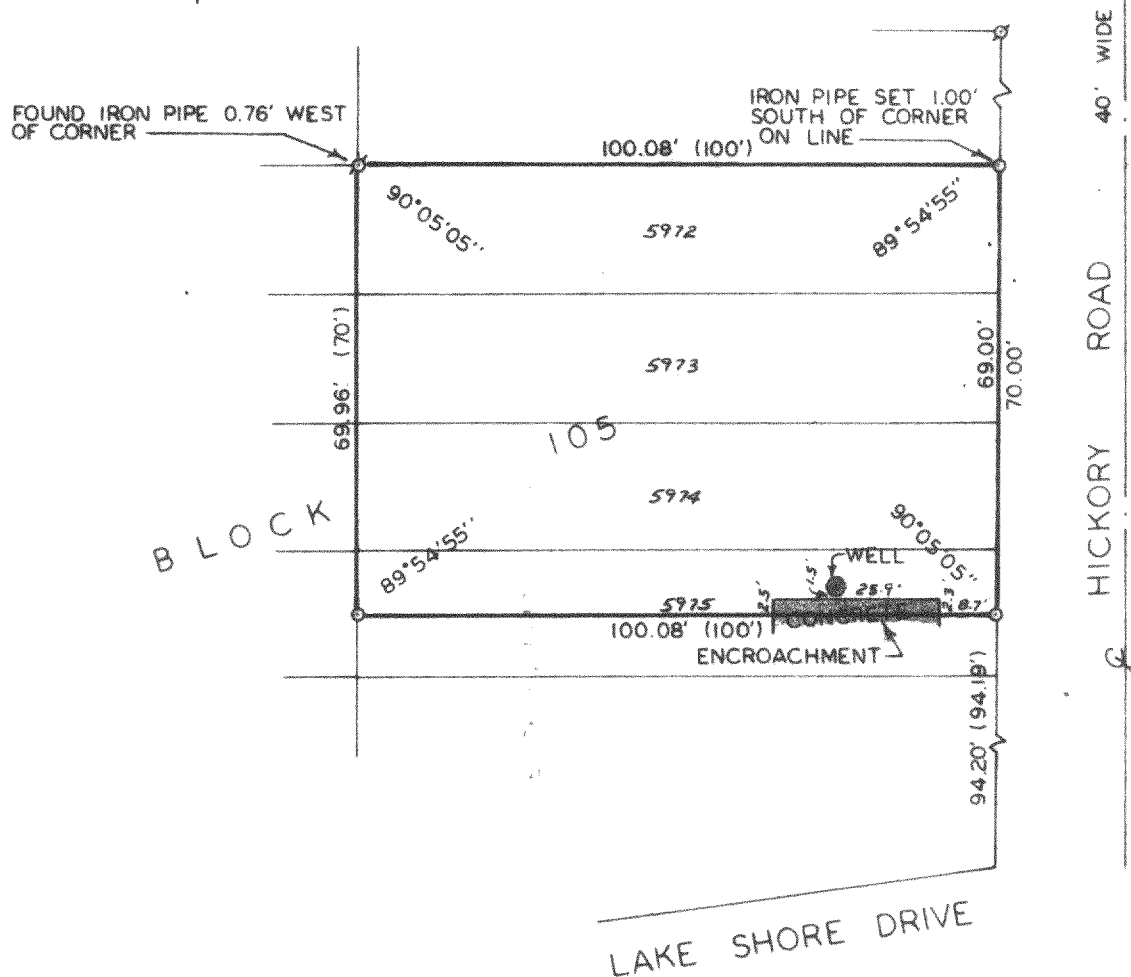

PLAT OF SURVEY OF

LOTS 5972-5974 AND THE NORTH  $\frac{1}{2}$  OF LOT 5975,  
BLOCK 105, LAKE COMO BEACH SUBDIVISION,  
T2N, R17E, WALWORTH COUNTY, WISCONSIN.

OWNERS: NANCY & ROY SAYLOR  
RT. 2, BOX 542-6  
LAKE GENEVA, WI 53147

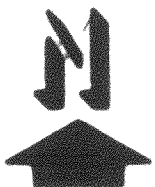

SCALE - 1"=30'

LEGEND

- o - IRON PIPE SET
- o - IRON PIPE FOUND
- () - RECORDED AS

I, HAROLD H. KOLB, DO HEREBY CERTIFY  
THAT I HAVE SURVEYED THE PROPERTY  
HEREON DESCRIBED ACCORDING TO THE  
OFFICIAL RECORDS, AND THAT THE PLAT  
HEREON IS A CORRECT REPRESENTATION  
OF THE LOT LINES TO THE BEST OF MY  
KNOWLEDGE AND BELIEF.

*Harold H. Kolb*  
HAROLD H. KOLB  
WISCONSIN REGISTERED LAND SURVEYOR, S-187  
DATE Sept. 20, 1982

JLKB-1325

217-590-K