



WALWORTH COUNTY
SURVEYING & MAPPING
LAKE GENEVA, WISCONSIN

CLEAR VIEW DRIVE

40' WIDE

PARK DRIVE
40' WIDE


ROADWAY
50' WIDE

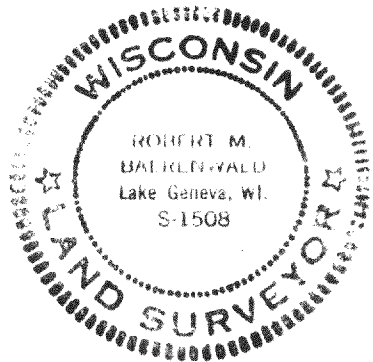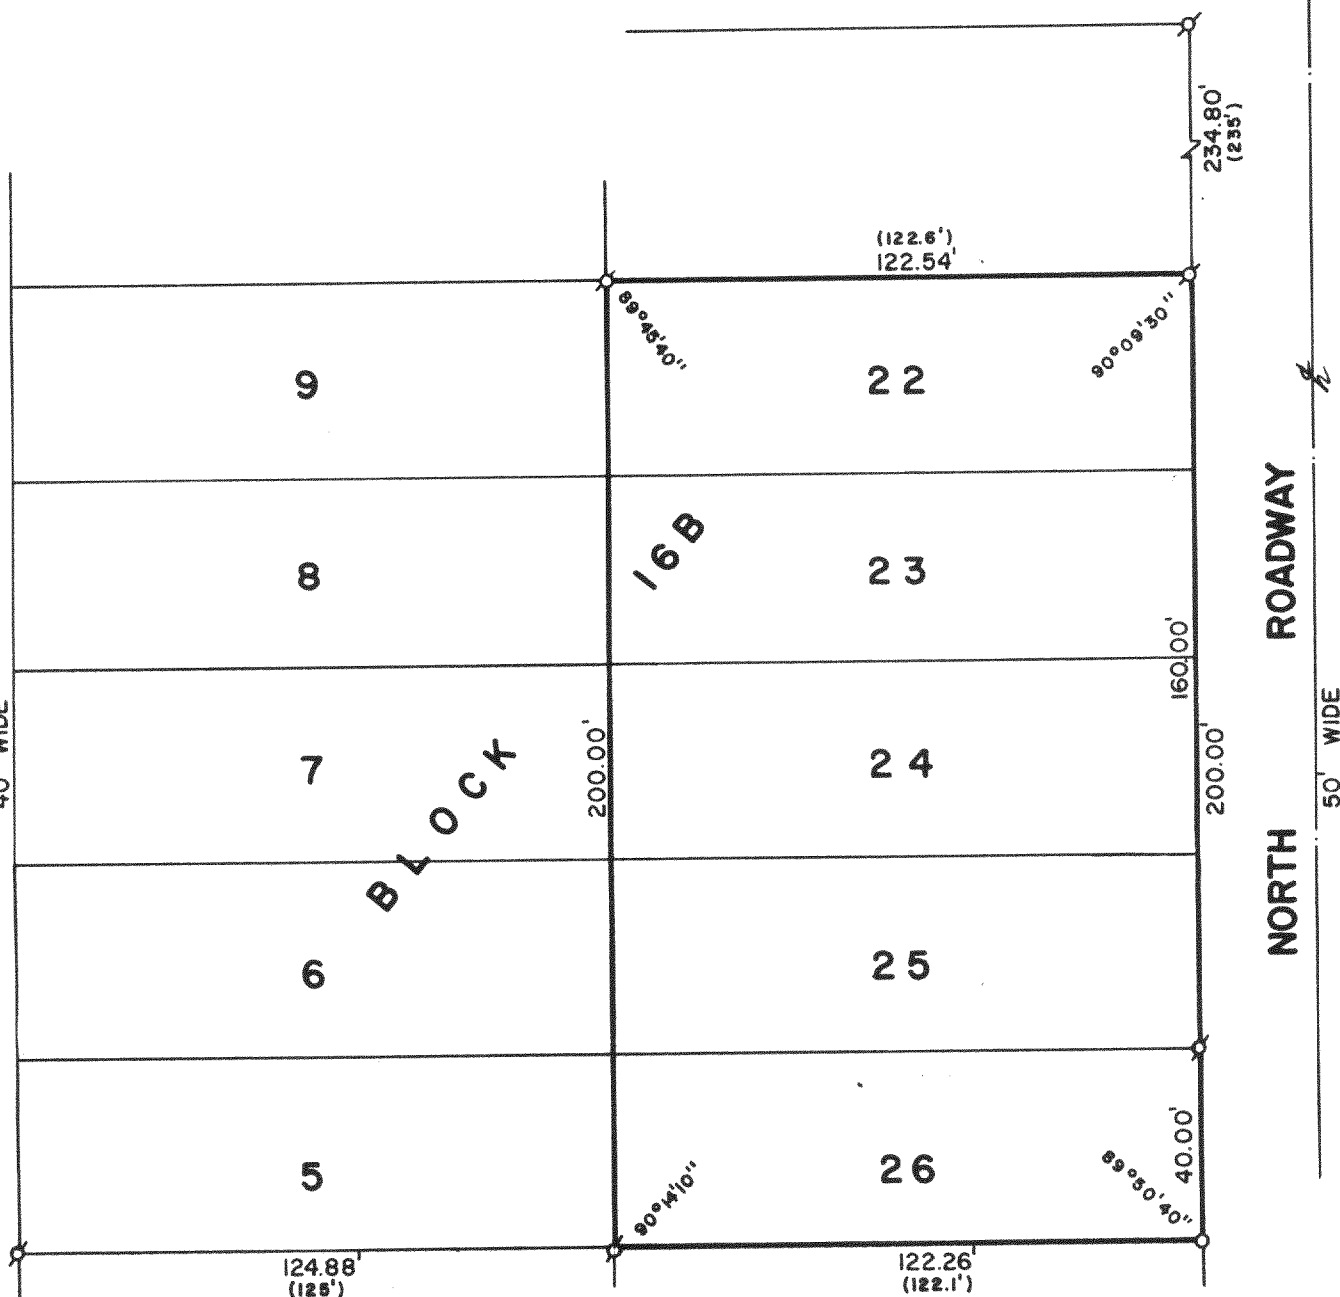

PLAT OF SURVEY OF

LOTS 22-26, BLOCK 16B OF SUNSET HILLS, LOCATED
IN SECTION 33, T 2 N, R 17 E, WALWORTH COUNTY,
WISCONSIN.

ORDERED BY: MARIE ROSENQUIST
RT. 4, BOX 1210
LAKE GENEVA, WISCONSIN

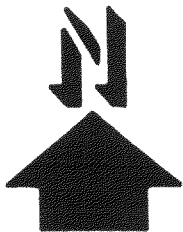

SCALE: 1"=40'

⊙ - IRON PIPE FOUND
○ - IRON PIPE PLACED
() - RECORDED AS

I, ROBERT M. BAERENWALD, DO HEREBY CERTIFY THAT I
HAVE SURVEYED THE PROPERTY HEREON DESCRIBED ACCORDING
TO THE OFFICIAL RECORDS AND THAT THE PLAT HEREON IS A
CORRECT REPRESENTATION OF THE PROPERTY LINES TO THE
BEST OF MY KNOWLEDGE AND BELIEF.

Robert M. Baerenwald
ROBERT M. BAERENWALD
WISCONSIN REGISTERED LAND SURVEYOR, S-1508

Sept. 19, 1984
DATE

JOB NO. 0119

217-594-13