


KOLB LAND CONSULTING, INC.
LAND SURVEYING • SUBDIVIDING • LAND PLANNING



LAKE GENEVA, WISCONSIN 53147

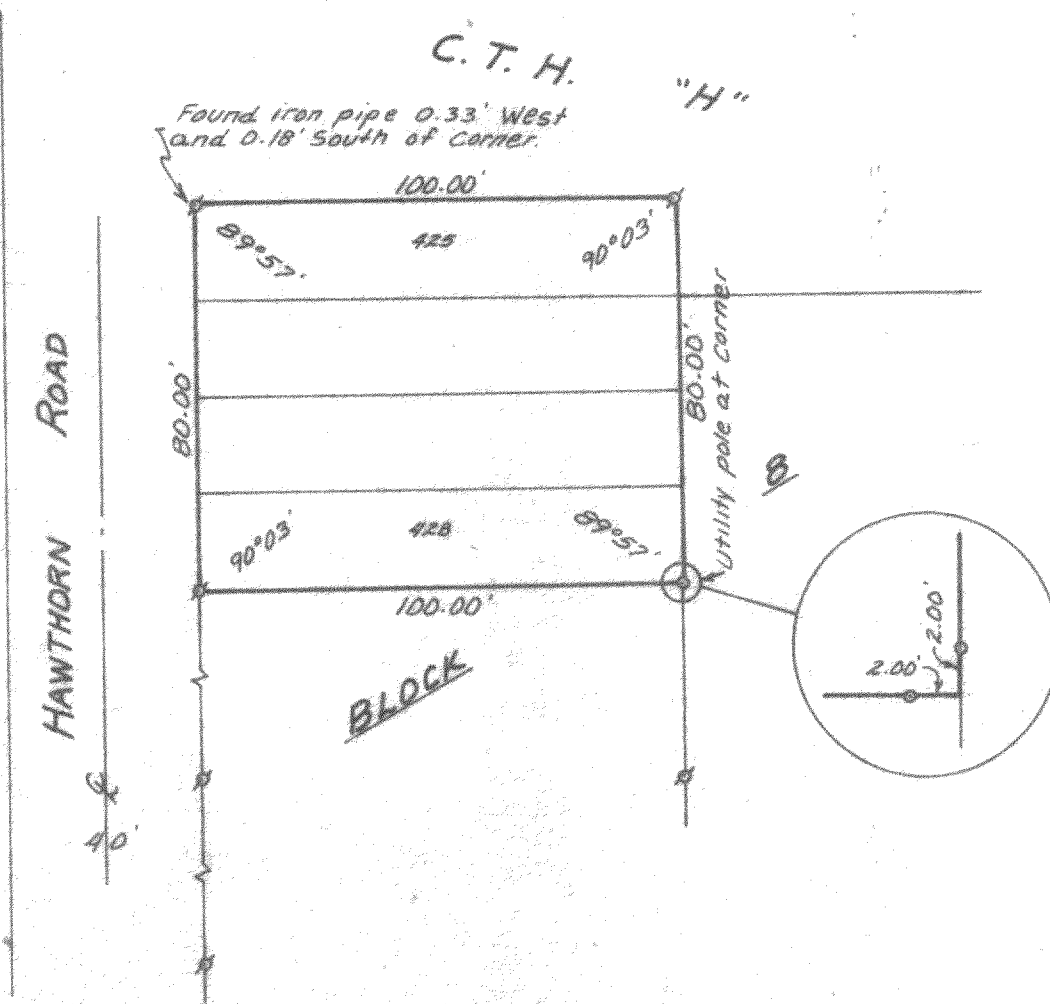

PLAT OF SURVEY OF

LOTS 425-428, BLOCK 8, LAKE COMO BEACH SURDIVISION,
T2N, R17E, WALWORTH COUNTY, WISCONSIN.

ORDERED BY: ANNA PIRO
8324 N. WAUKEGAN RD.
NILES, IL 60648

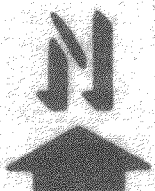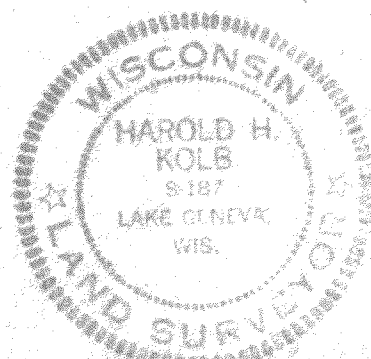

SCALE - 1"=40'

LEGEND

- - IRON PIPE FOUND
- o - IRON PIPE SET

I, HAROLD H. KOLB, DO HEREBY CERTIFY
THAT I HAVE SURVEYED THE PROPERTY
HEREON DESCRIBED ACCORDING TO THE
OFFICIAL RECORDS, AND THAT THE PLAT
HEREON IS A CORRECT REPRESENTATION
OF THE LOT LINES TO THE BEST OF MY
KNOWLEDGE AND BELIEF.

Harold H. Kolb

HAROLD H. KOLB
WISCONSIN REGISTERED LAND SURVEYOR, S-187

DATE March 25, 1985