


Hickory Road 40' WIDE

Woodland Drive 40' WIDE

Como Rd.
50' WIDE

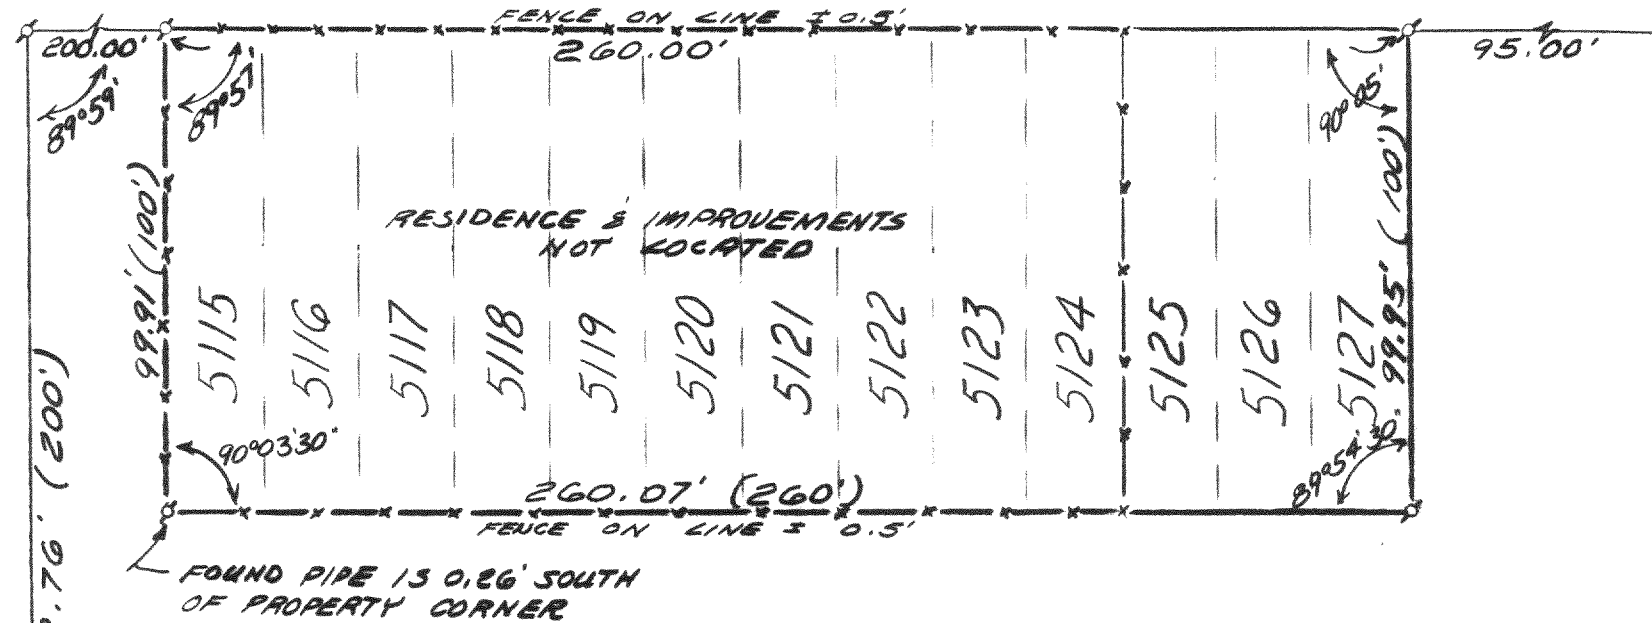


Plat of Survey of Lots 5115-5127 of Block 90 of
Lake Como Beach Subdivision Town of Geneva,
Walworth Co., Wisconsin

Work Ordered By Mikrut Realty
for Martin & Maria Ilczyszyn

Orchid Dr.

Farris, Hansen & Associates, Inc.

Engineering, Surveying & Land Planning
P.O. BOX 487
715 W. WALWORTH STREET
ELKHORN, WISCONSIN 53121

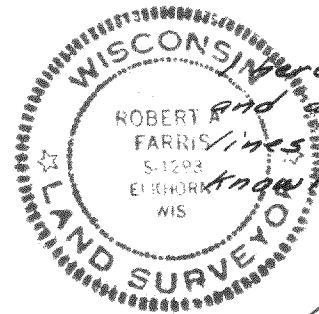

I hereby certify that this Plat is a true
and accurate representation of the lot
lines to the best of my professional
knowledge and belief.

Robert A. Farris

July 12, 1984

PROJ.# 2286