

Farris, Hansen & Associates, Inc.

Engineering, Surveying & Land Planning


P.O. BOX 487

715 W. WALWORTH STREET


ELKHORN, WISCONSIN 53121

PLAT OF SURVEY OF LOTS 12099 - 12108 OF
BLOCK 216 OF LAKE COMO BEACH SUBDIVISION TOWN OF
GENEVA, WALWORTH COUNTY, WISCONSIN

W. line Canary Road assumed to bear
N 0° 20' 04" E as shown on original
plat

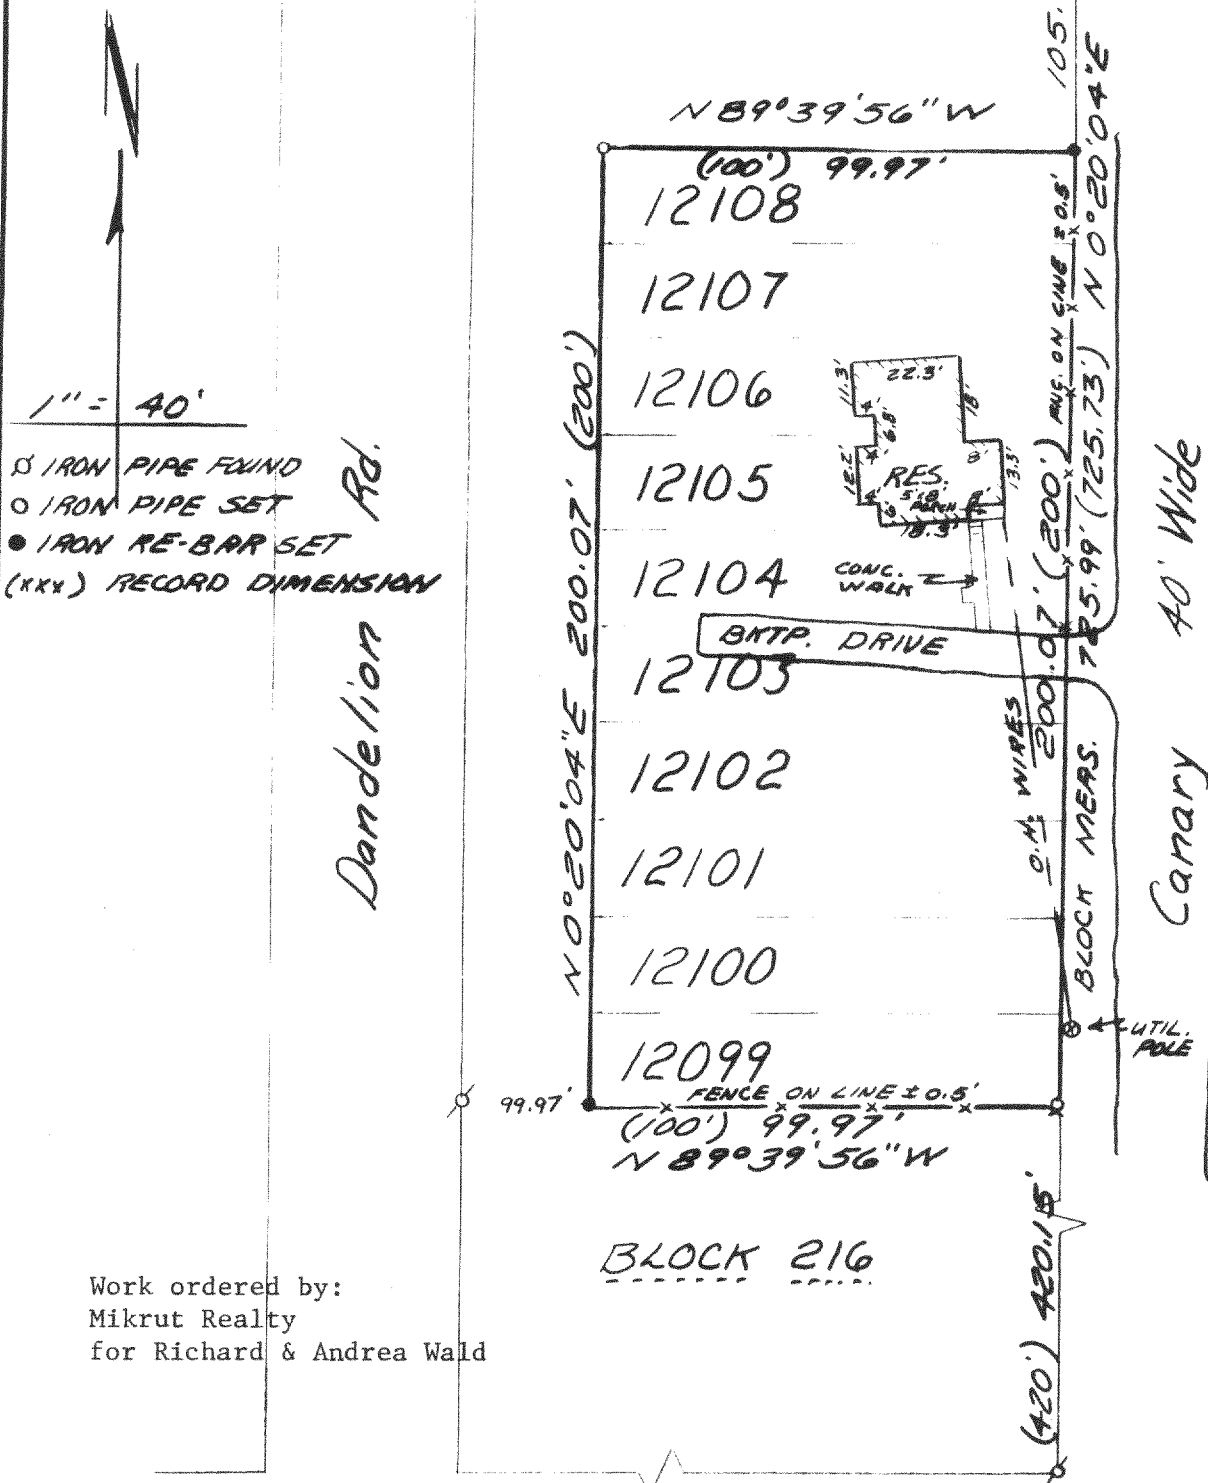

Work ordered by:
Mikrut Realty
for Richard & Andrea Wald

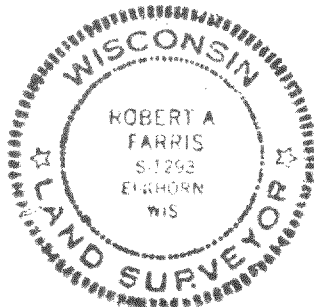

I hereby certify that I have surveyed the above described property and that the above map is a true representation thereof and shows the size and location of the property, its exterior boundaries, the location of all visible structures and dimensions of all principal buildings thereon, boundary fences, apparent easements, roadways and visible encroachments, if any.

This survey is made for the use of the present owners of the property, and also those who purchase, mortgage, or guarantee the title thereto within one (1) year from date hereof.

Robert A. Farris

JULY 12, 1984 - PROJ. #2283