


KOLB LAND CONSULTING, INC.

LAND SURVEYING • SUBDIVIDING • LAND PLANNING

LAKE GENEVA, WISCONSIN 53147

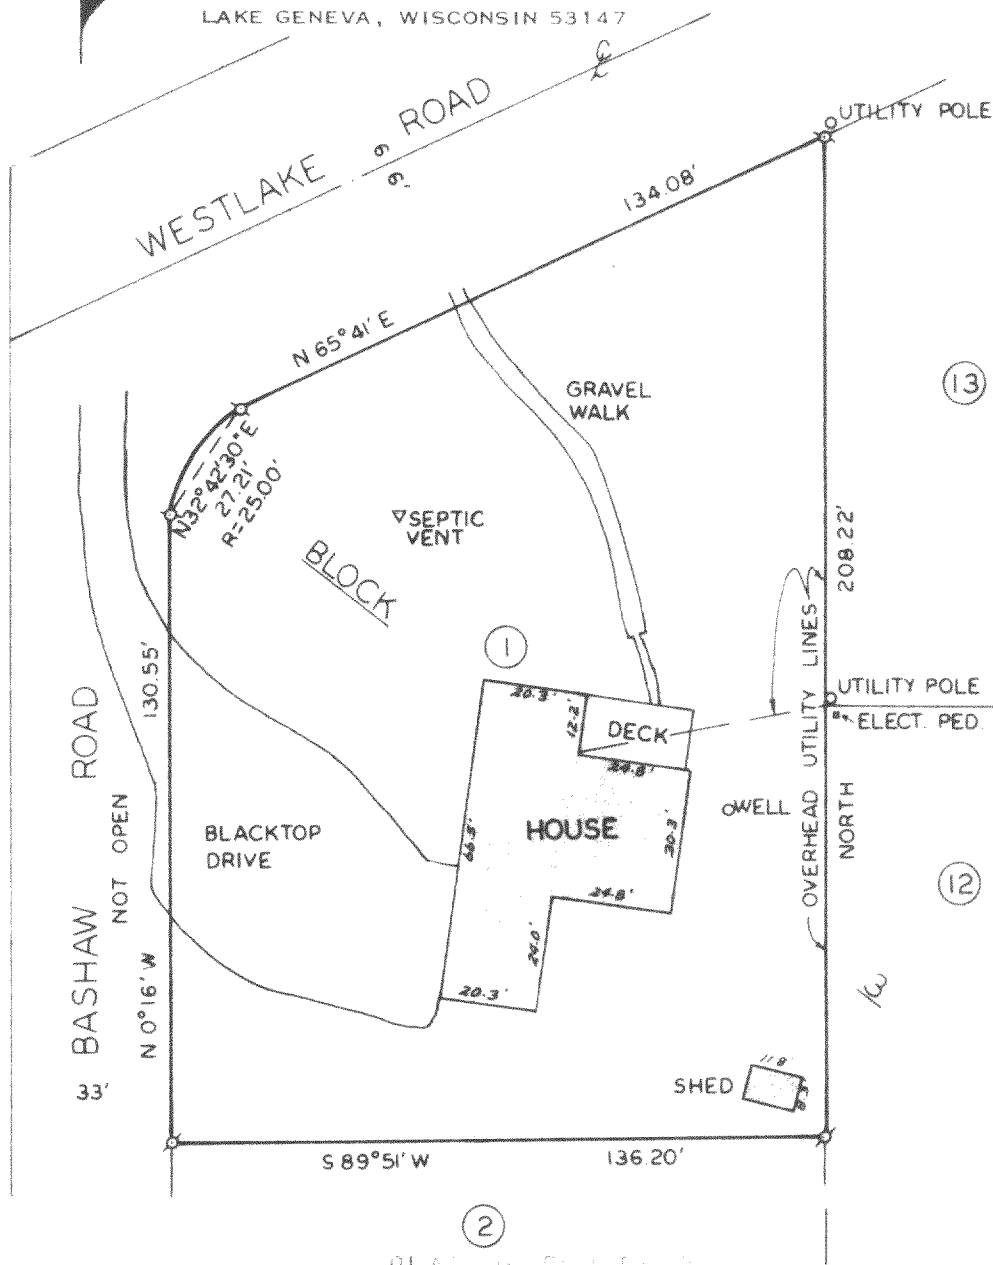


PLAN OF SURVEY

LOT 1, BLOCK 2, HAWTHORNE HILL, T2N, R17E, WALWORTH COUNTY, WISCONSIN.

ORDERED BY: JOHN SARKIS, JR.
Rt. 4, Box 144
LAKE GENEVA, WI 53147

I HEREBY CERTIFY THAT I HAVE SURVEYED THE ABOVE DESCRIBED PROPERTY AND THAT THE ABOVE MAP IS A TRUE REPRESENTATION THEREOF AND SHOWS THE SIZE AND LOCATION OF THE PROPERTY, ITS EXTERIOR BOUNDARIES, THE LOCATION OF ALL VISIBLE STRUCTURES AND DIMENSIONS OF ALL PRINCIPAL UTILITIES THEREON, BOUNDARY FINCHES, APPARENT EASEMENTS, AND ALWAYS VISIBLE ENCROACHMENTS, IF ANY.

THIS SURVEY IS MADE FOR THE USE OF THE PRESENT OWNERS OF THE PROPERTY, AND ALSO THOSE WHO PURCHASE, MORTGAGE, OR GUARANTEE THE TITLE HEREON WITHIN ONE YEAR OF THE DATE HEREOF.

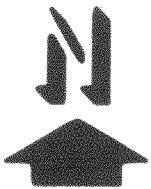

SCALE 1"=40'

LEGEND

∘ - IRON PIPE FOUND

Harold H. Kolb

HAROLD H. KOLB
WISCONSIN REGISTERED LAND SURVEYOR, S-187
DATE NOVEMBER 27, 1985

JHH 00017

2-17-405 2.17-598-K