


PLAT OF SURVEY OF LOT 11 OF
INDIAN ECHO ESTATES LOC. IN
SEC. 34, TOWN OF GENEVA,
WALWORTH COUNTY, WIS.
FOR
BUYER: CROWELL
SELLER: GIBSON

Legend

- = IRON ROD STAKE FOUND
- = IRON PIPE STAKE FOUND
- = UTILITY POLE
- = SUBSTANTIAL FENCE
- = OVERHEAD WIRES
- = LEGAL CENTERLINE
- (XXX) = ORIG. SUB. PLAT DIMENSION

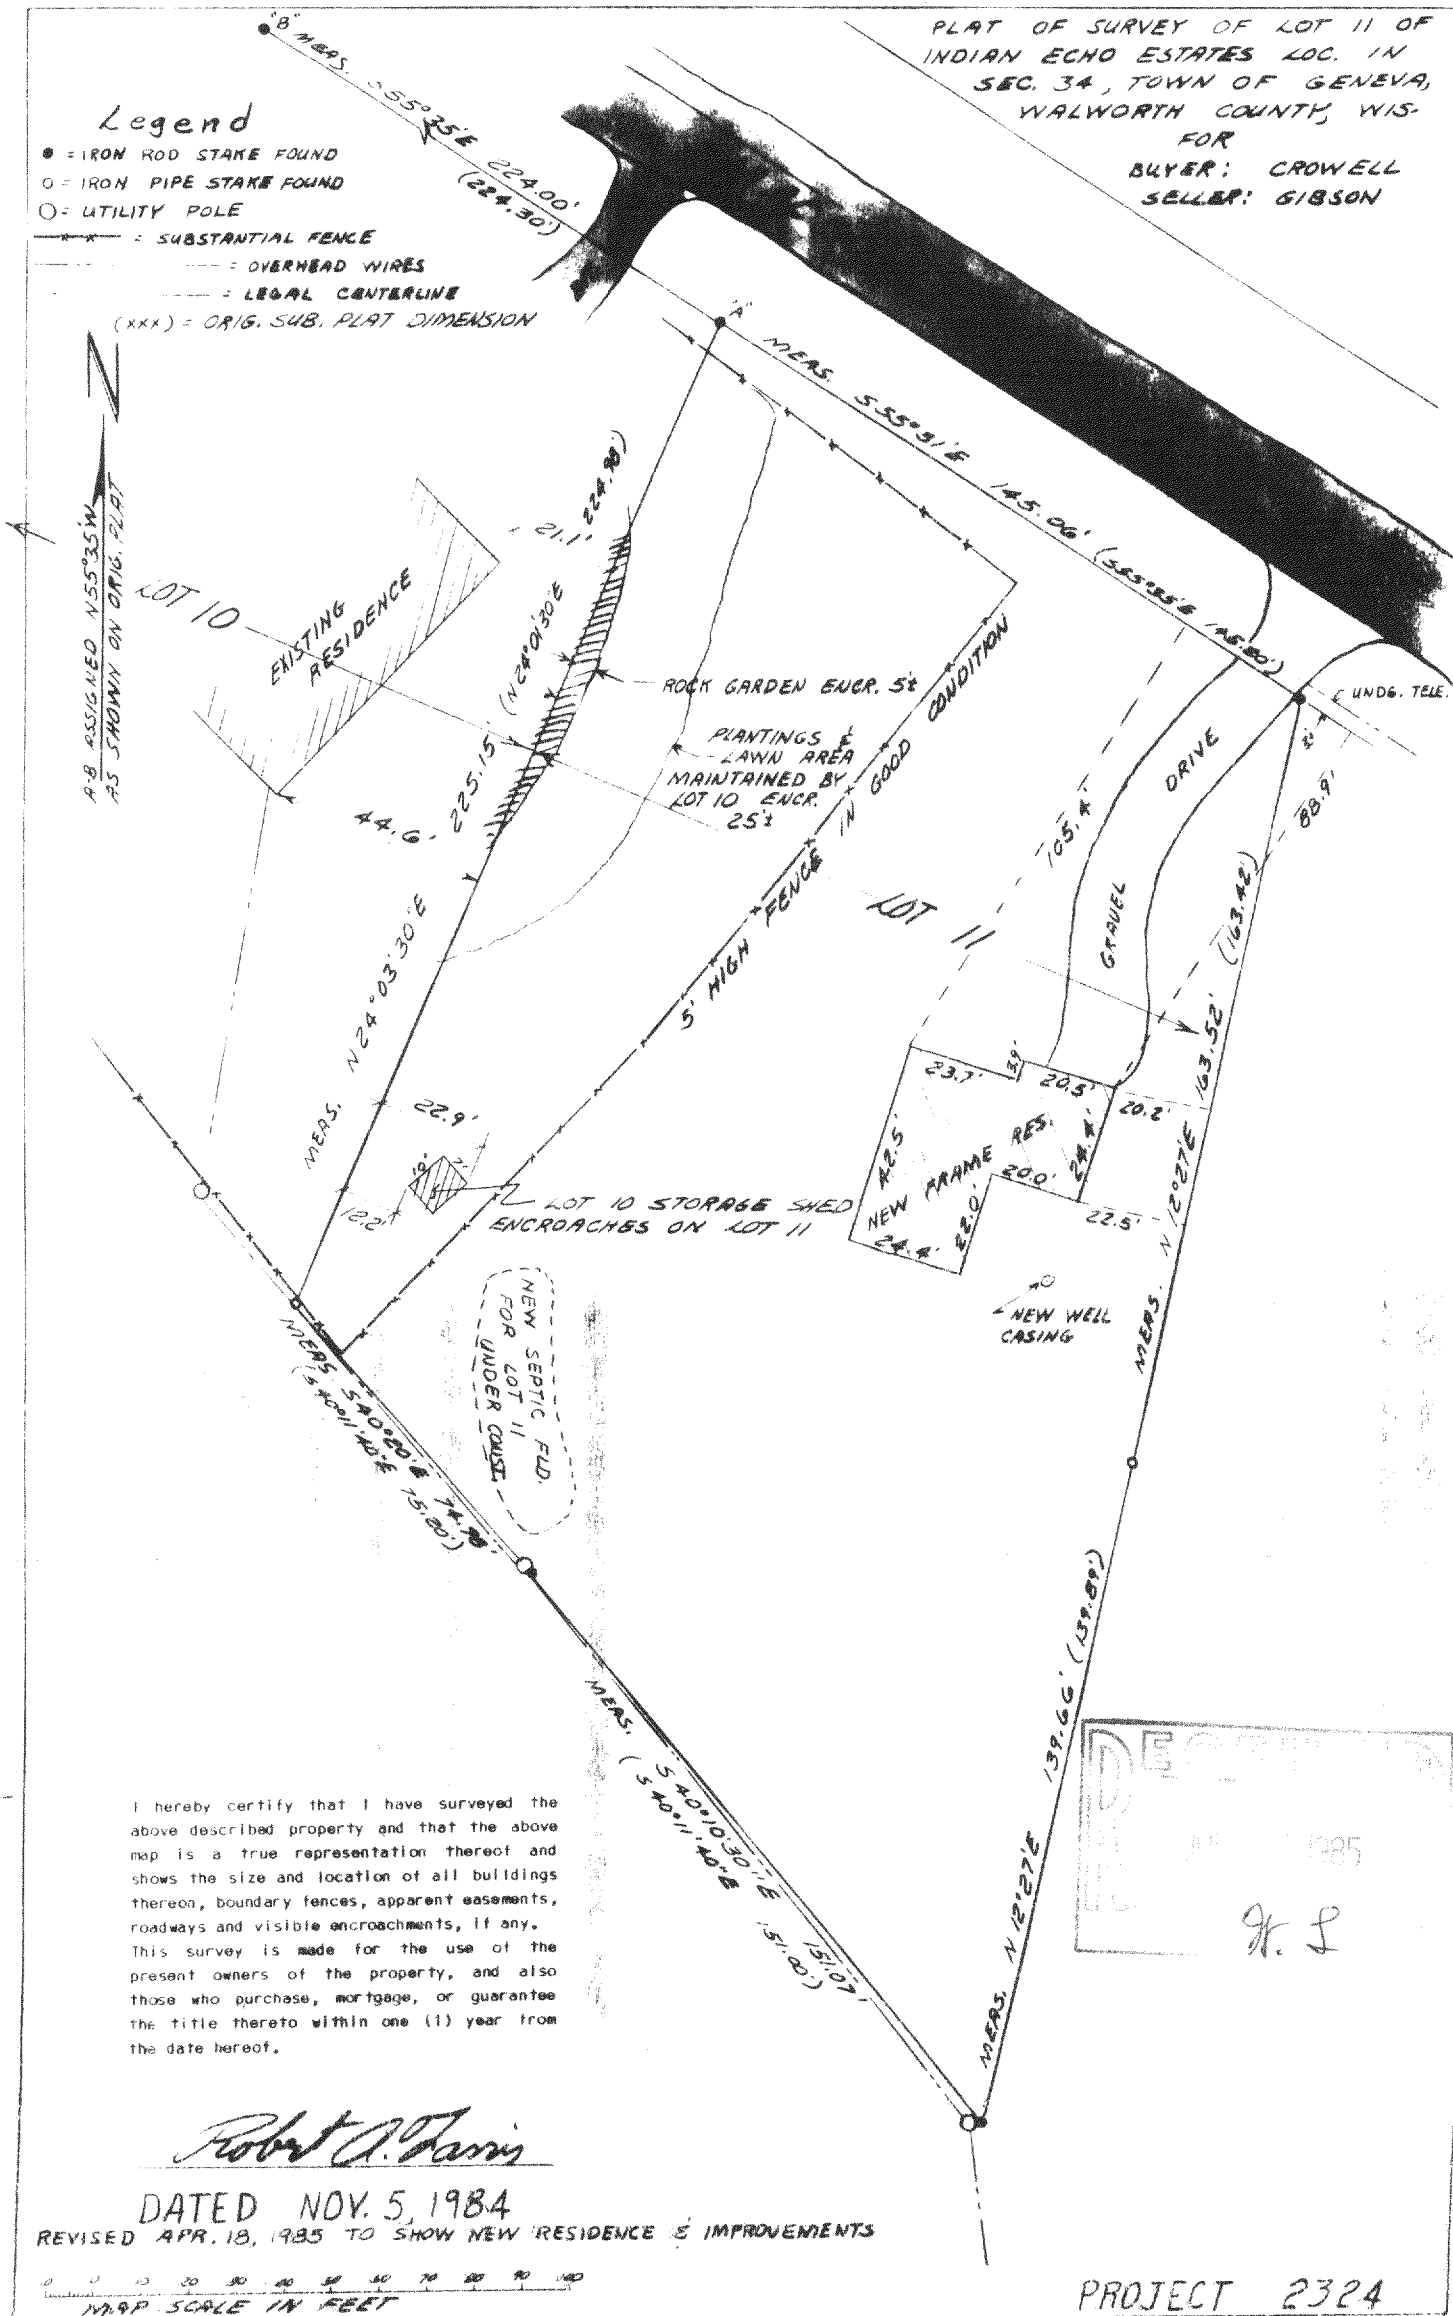

I hereby certify that I have surveyed the above described property and that the above map is a true representation thereof and shows the size and location of all buildings thereon, boundary fences, apparent easements, roadways and visible encroachments, if any. This survey is made for the use of the present owners of the property, and also those who purchase, mortgage, or guarantee the title thereto within one (1) year from the date hereof.

Robert J. Jarvis

DATED NOV. 5, 1984

REVISED APR. 18, 1985 TO SHOW NEW RESIDENCE & IMPROVEMENTS

0 10 20 30 40 50 60 70 80 90 100
MAP SCALE IN FEET

PROJECT 2324

217-599-F ✓✓


Legend

- = IRON ROD STAKE FOUND
- = IRON PIPE STAKE FOUND
- = UTILITY POLE
- = SUBSTANTIAL FENCE
- - - = OVERHEAD WIRES
- - - = LEGAL CENTERLINE
- (XXX) = ORIG. SUB. PLAT DIMENSION

PLAT OF SURVEY OF LOT 11 OF
INDIAN ECHO ESTATES LOC. IN
SEC. 34, TOWN OF GENEVA,
WALWORTH COUNTY, WIS.



FOR
BUYER: CROWELL
SELLER: GIBSON

MACDONALD
ROAD

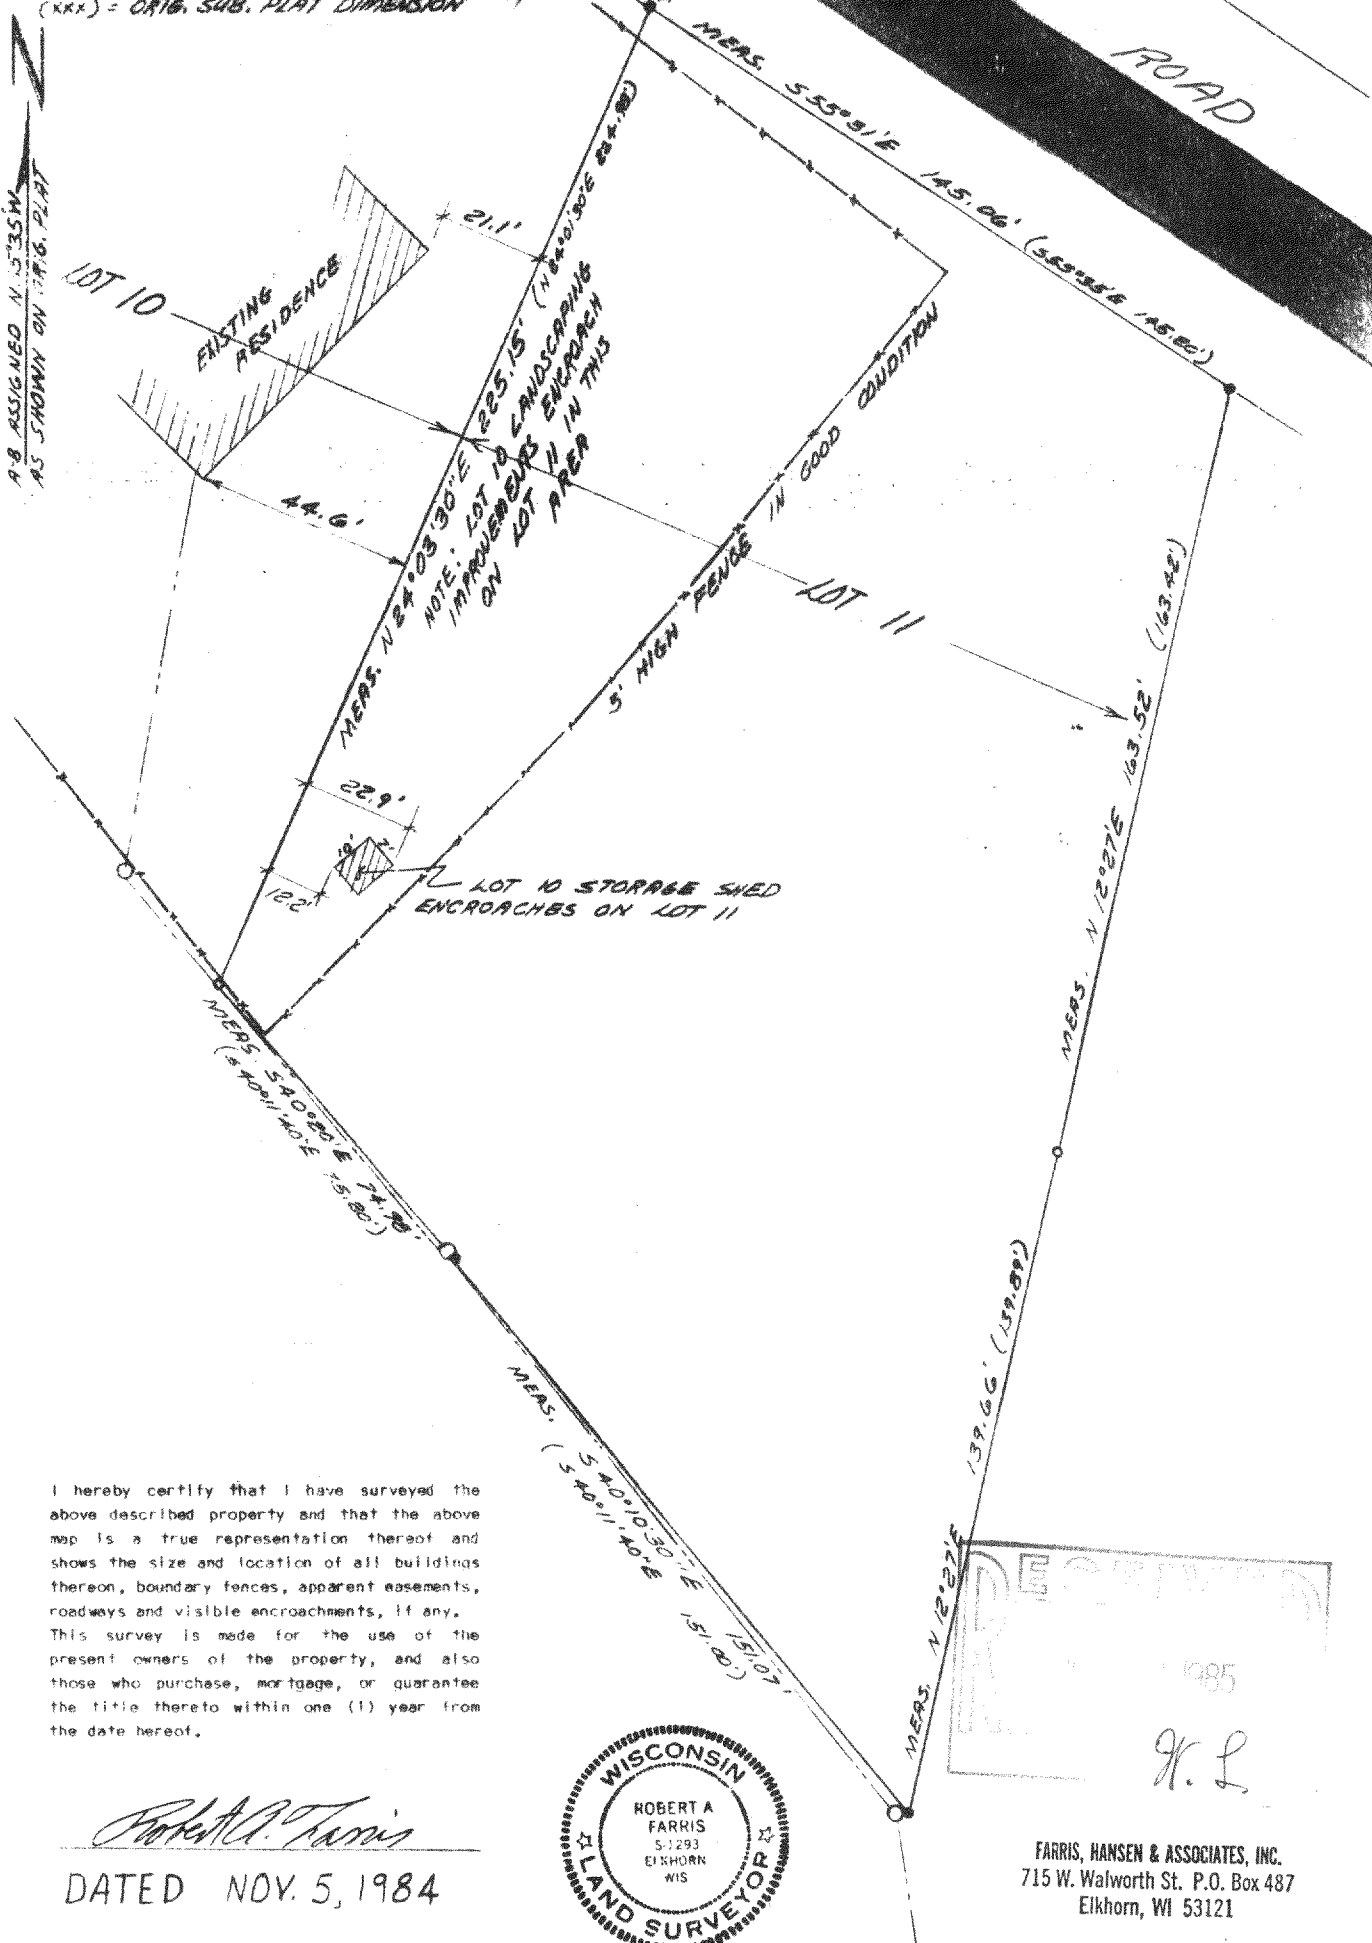

I hereby certify that I have surveyed the above described property and that the above map is a true representation thereof and shows the size and location of all buildings thereon, boundary fences, apparent easements, roadways and visible encroachments, if any. This survey is made for the use of the present owners of the property, and also those who purchase, mortgage, or guarantee the title thereto within one (1) year from the date hereof.

Robert A. Farris
DATED NOV. 5, 1984

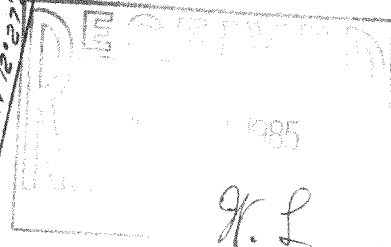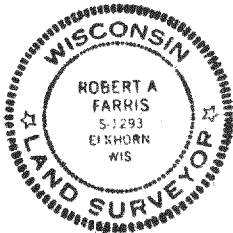

FARRIS, HANSEN & ASSOCIATES, INC.
715 W. Walworth St. P.O. Box 487
Elkhorn, WI 53121

PROJECT 2324