

L I N C O L N D R I V E


N

SCALE-1"=20'
O=IRON PIPE

R O A D

R O B I N

40'

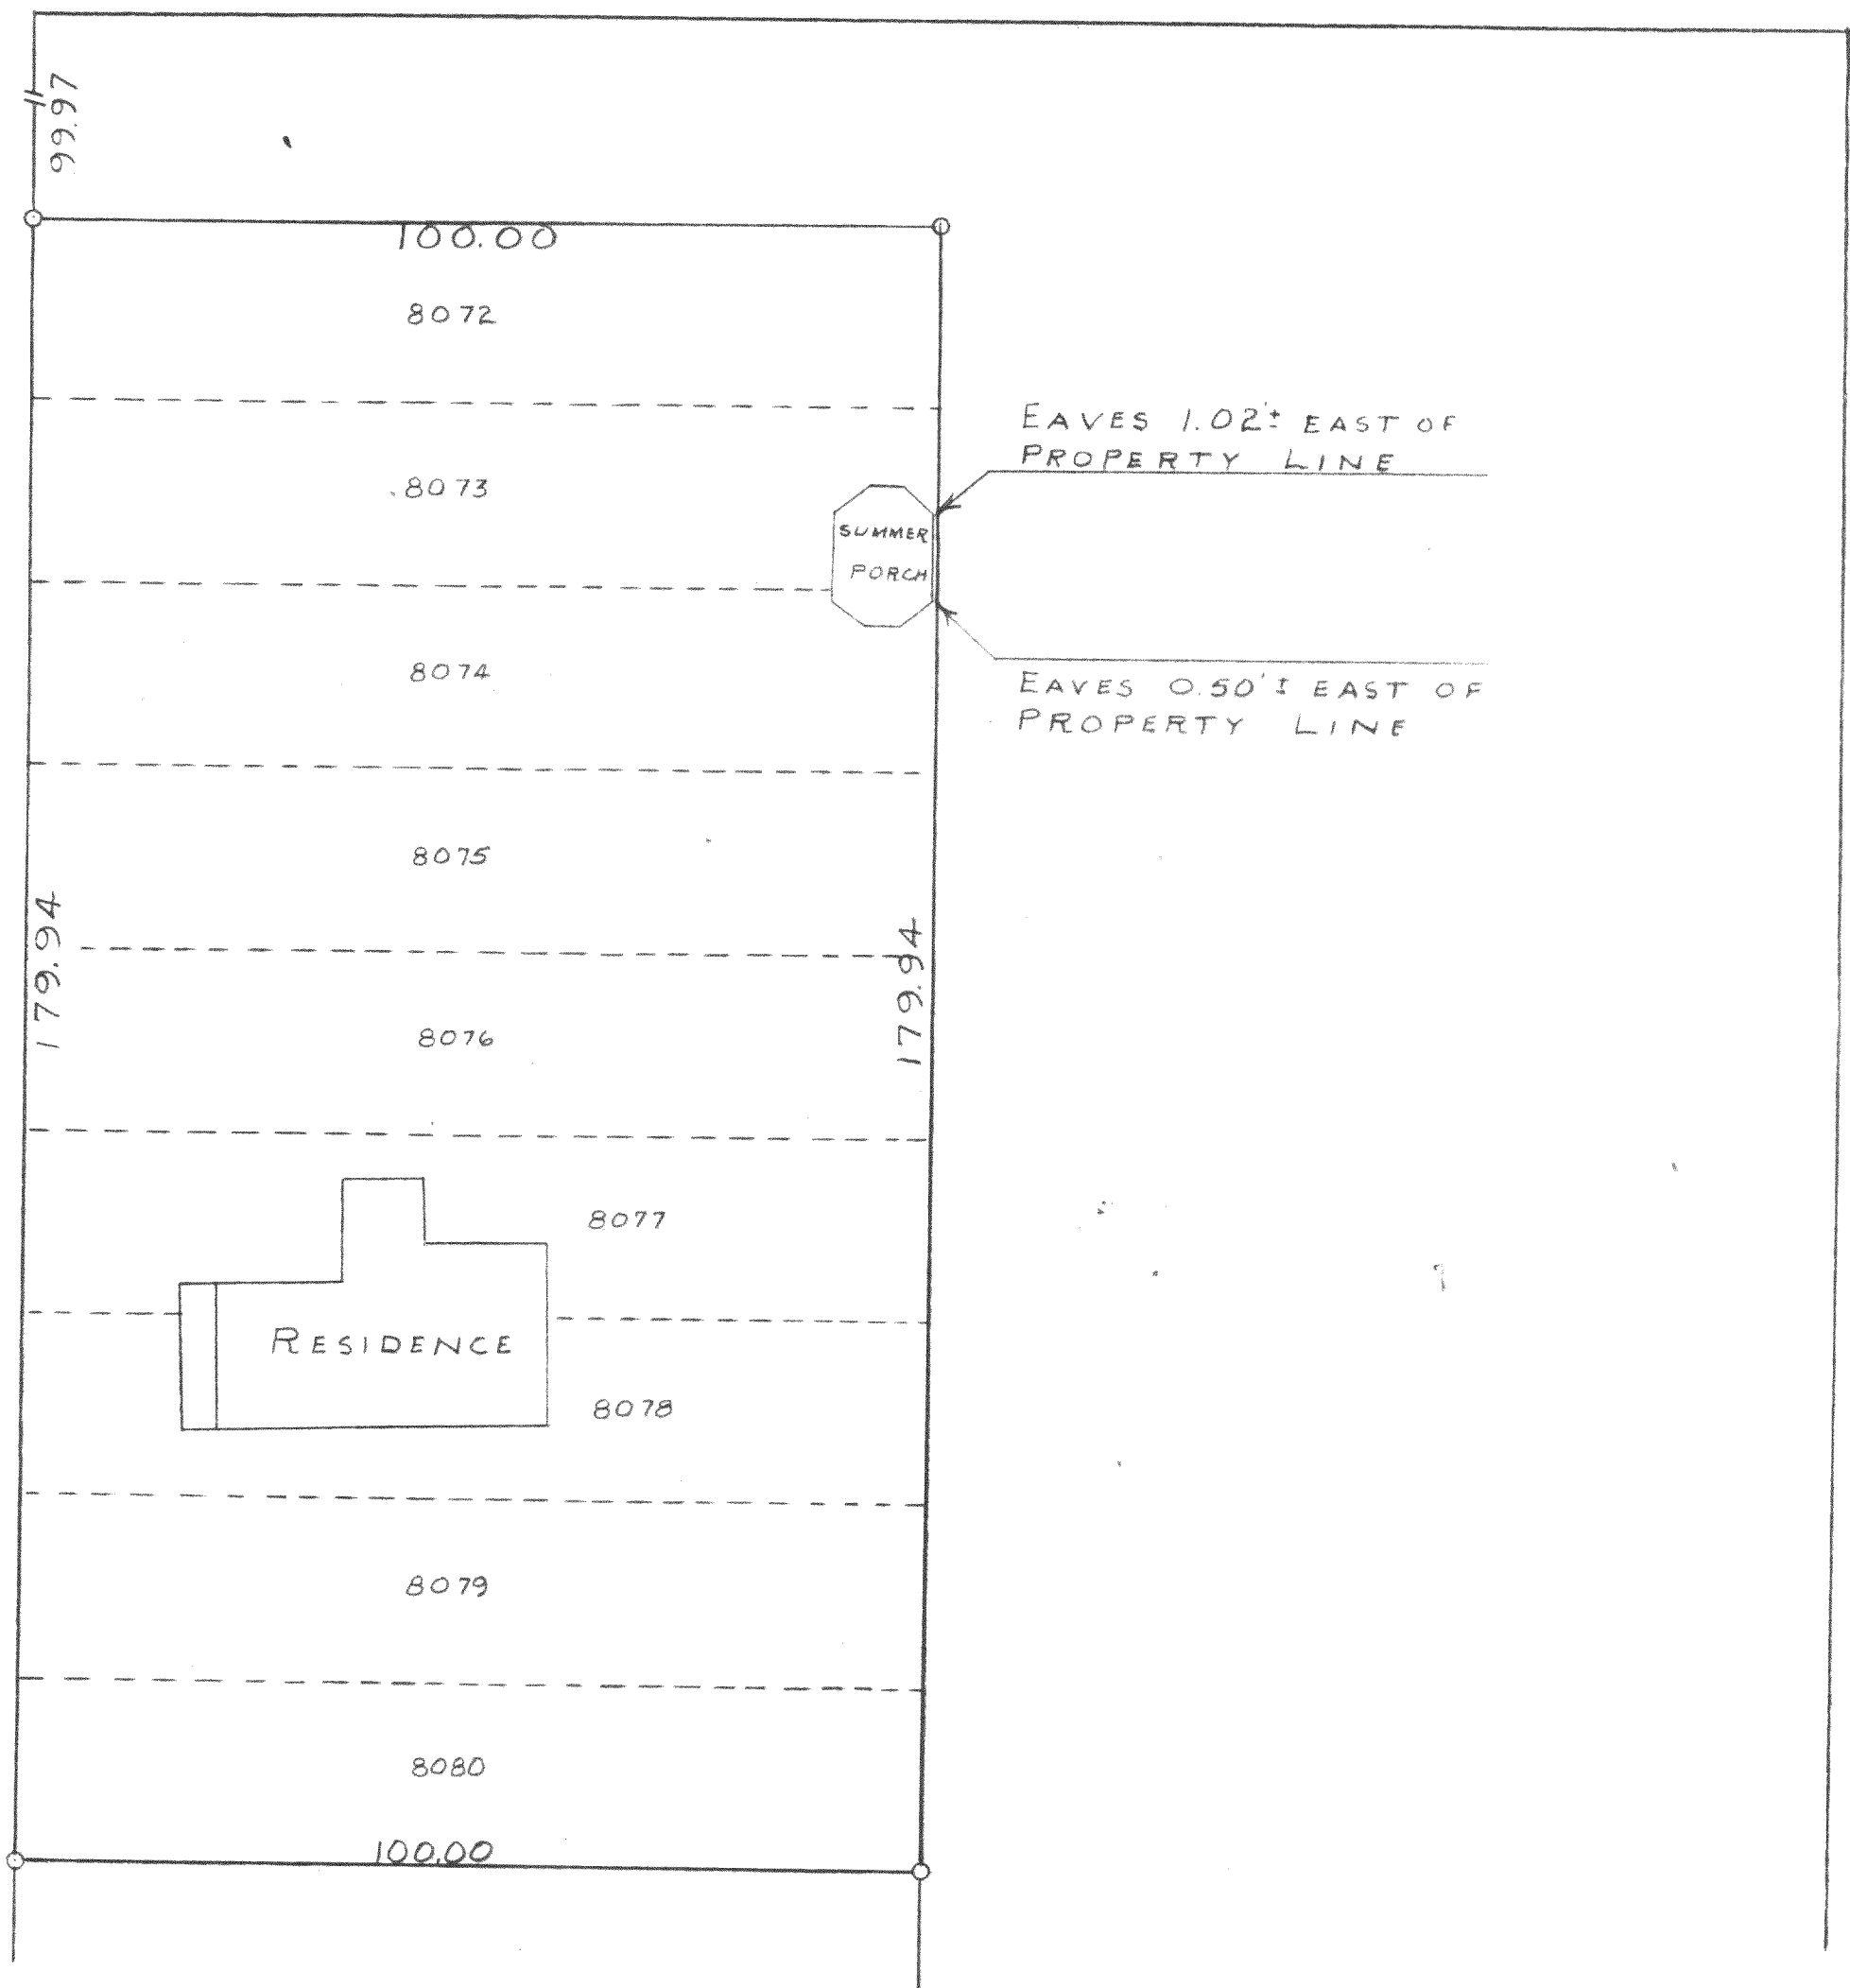

R O A D

Q U A I L

PLAT OF SURVEY OF LOTS 8072-8080 INCLUSIVE IN LAKE COMO
BEACH SUBDIVISION, TOWN OF GENEVA, WALWORTH COUNTY, WISCONSIN
AUGUST 12, 1955

George F. Dunham
GEORGE F. DUNHAM, SURVEYOR
DELAVER, WISCONSIN