


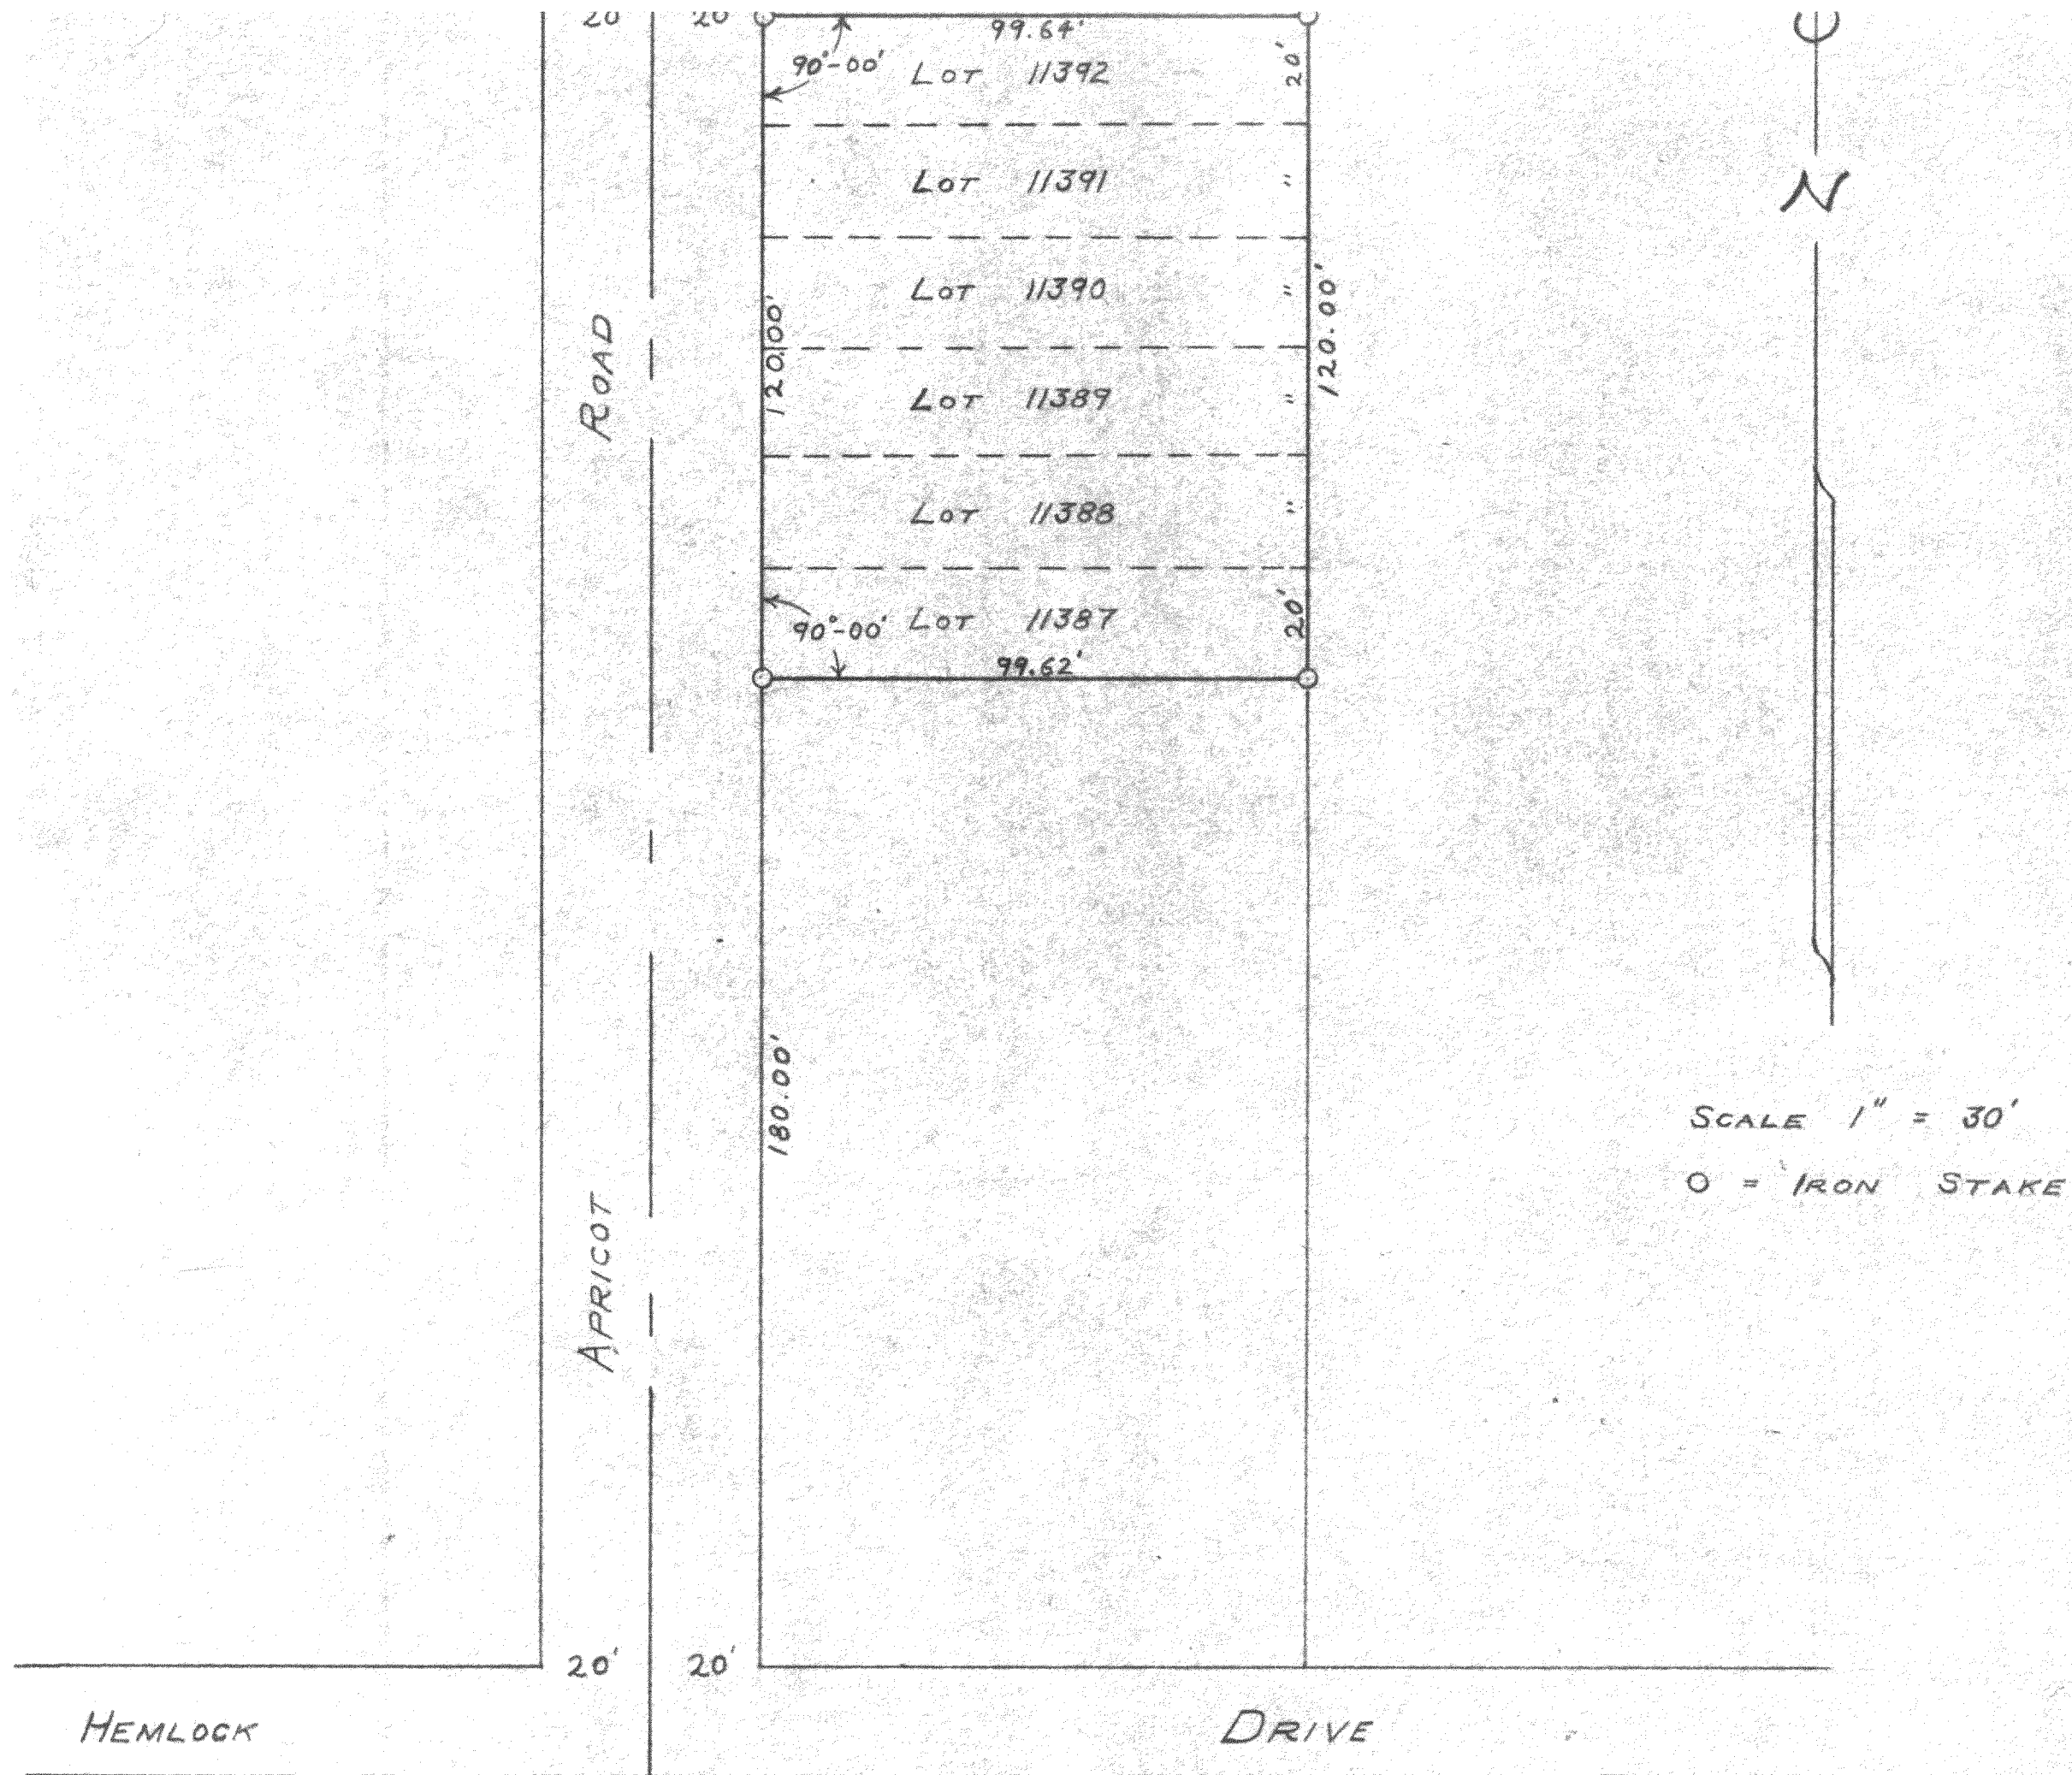

PLAT OF SURVEY OF LOTS 11387 TO
 11392 INCLUSIVE, OF LAKE COMO BEACH
 SUBDIVISION WALWORTH COUNTY, WISCONSIN
 APRIL 2, 1952

Lloyd L. Jensen
 COUNTY SURVEYOR

JLCS-2476

217-6001