



ANDERSON LAND SURVEYING


DELAVAN, WIS. 53115

728-2525

PLAT OF SURVEY

DESCRIPTION: Lots 2245, 2246, 2247, 2248, 2249, 2250, 2251, and also Lots 2399 and 2400 all in the Lake Como Beach Subdivision, being a part of Section 27, T.2 N., R.17 E. of the 4th P.M., Town of Geneva, Walworth County, Wisconsin.

PREPARED FOR: Citizens Bank of Delavan
Delavan, Wis. 53115

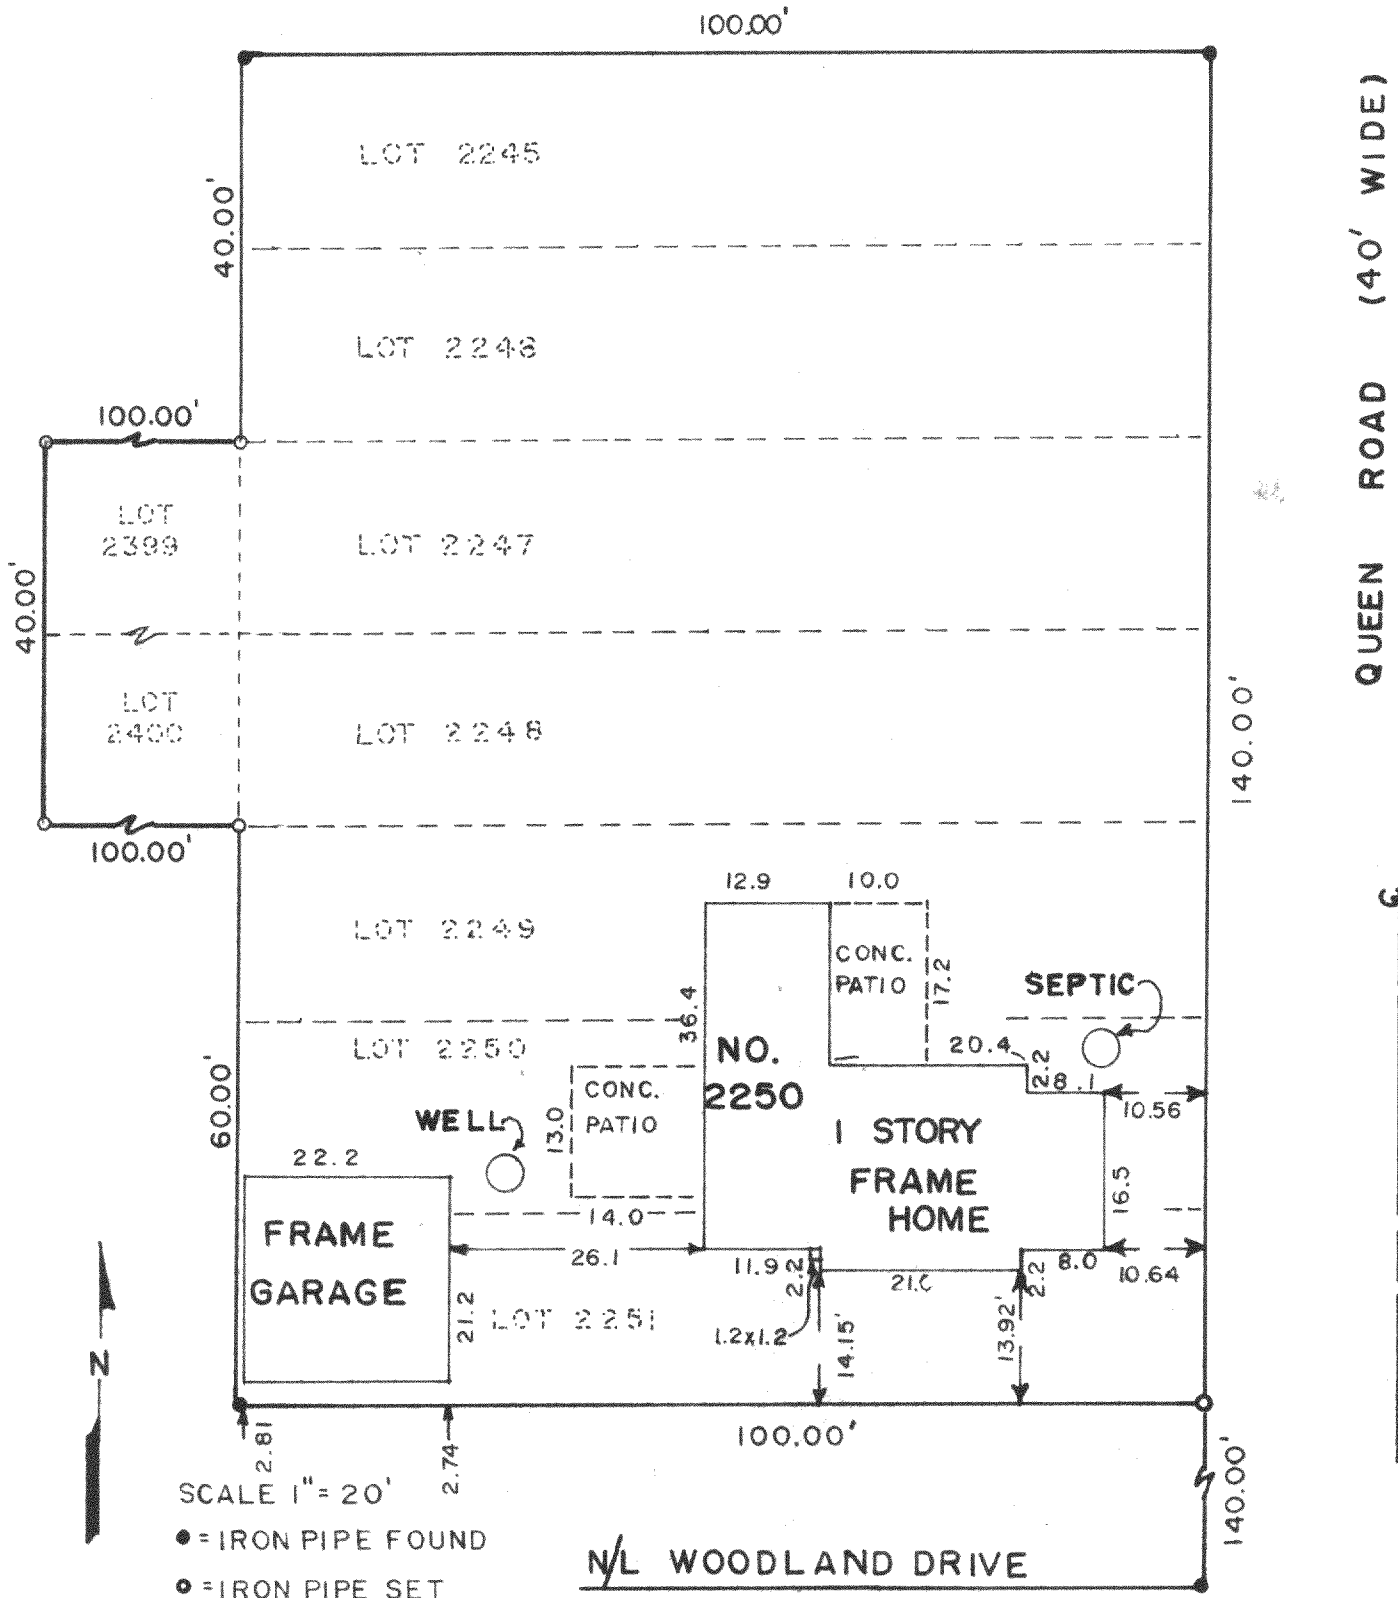

SURVEYOR'S CERTIFICATE

I HEREBY CERTIFY THAT I HAVE SURVEYED THE ABOVE DESCRIBED PROPERTY AND THE ABOVE MAP IS A TRUE REPRESENTATION THEREOF AND SHOWS THE SIZE AND LOCATION OF THE PROPERTY, ITS EXTERIOR BOUNDARIES, THE LOCATION AND DIMENSIONS OF ALL VISIBLE STRUCTURES THEREON. THIS SURVEY IS MADE FOR THE EXCLUSIVE USE OF THE PRESENT OWNERS OF THE PROPERTY, AND ALSO THOSE WHO PURCHASE, MORTGAGE, OR GUARANTEE THE TITLE THERETO WITHIN ONE (1) YEAR FROM DATE HEREOF.

DATE

7/27/84

SURVEYOR

Ralph L. Anderson
R.L.S. #1327

JOB NO.

20384

15 FEB. 85

JLCB-385,409

217-600