


PLAT OF SURVEY OF LOTS 5461, 5462, 5463, 5464, AND 5465 OF BLOCK 98 OF LAKE COMO BEACH, A SUBDIVISION LOCATED IN THE TOWN OF GENEVA, WALWORTH COUNTY, WISCONSIN

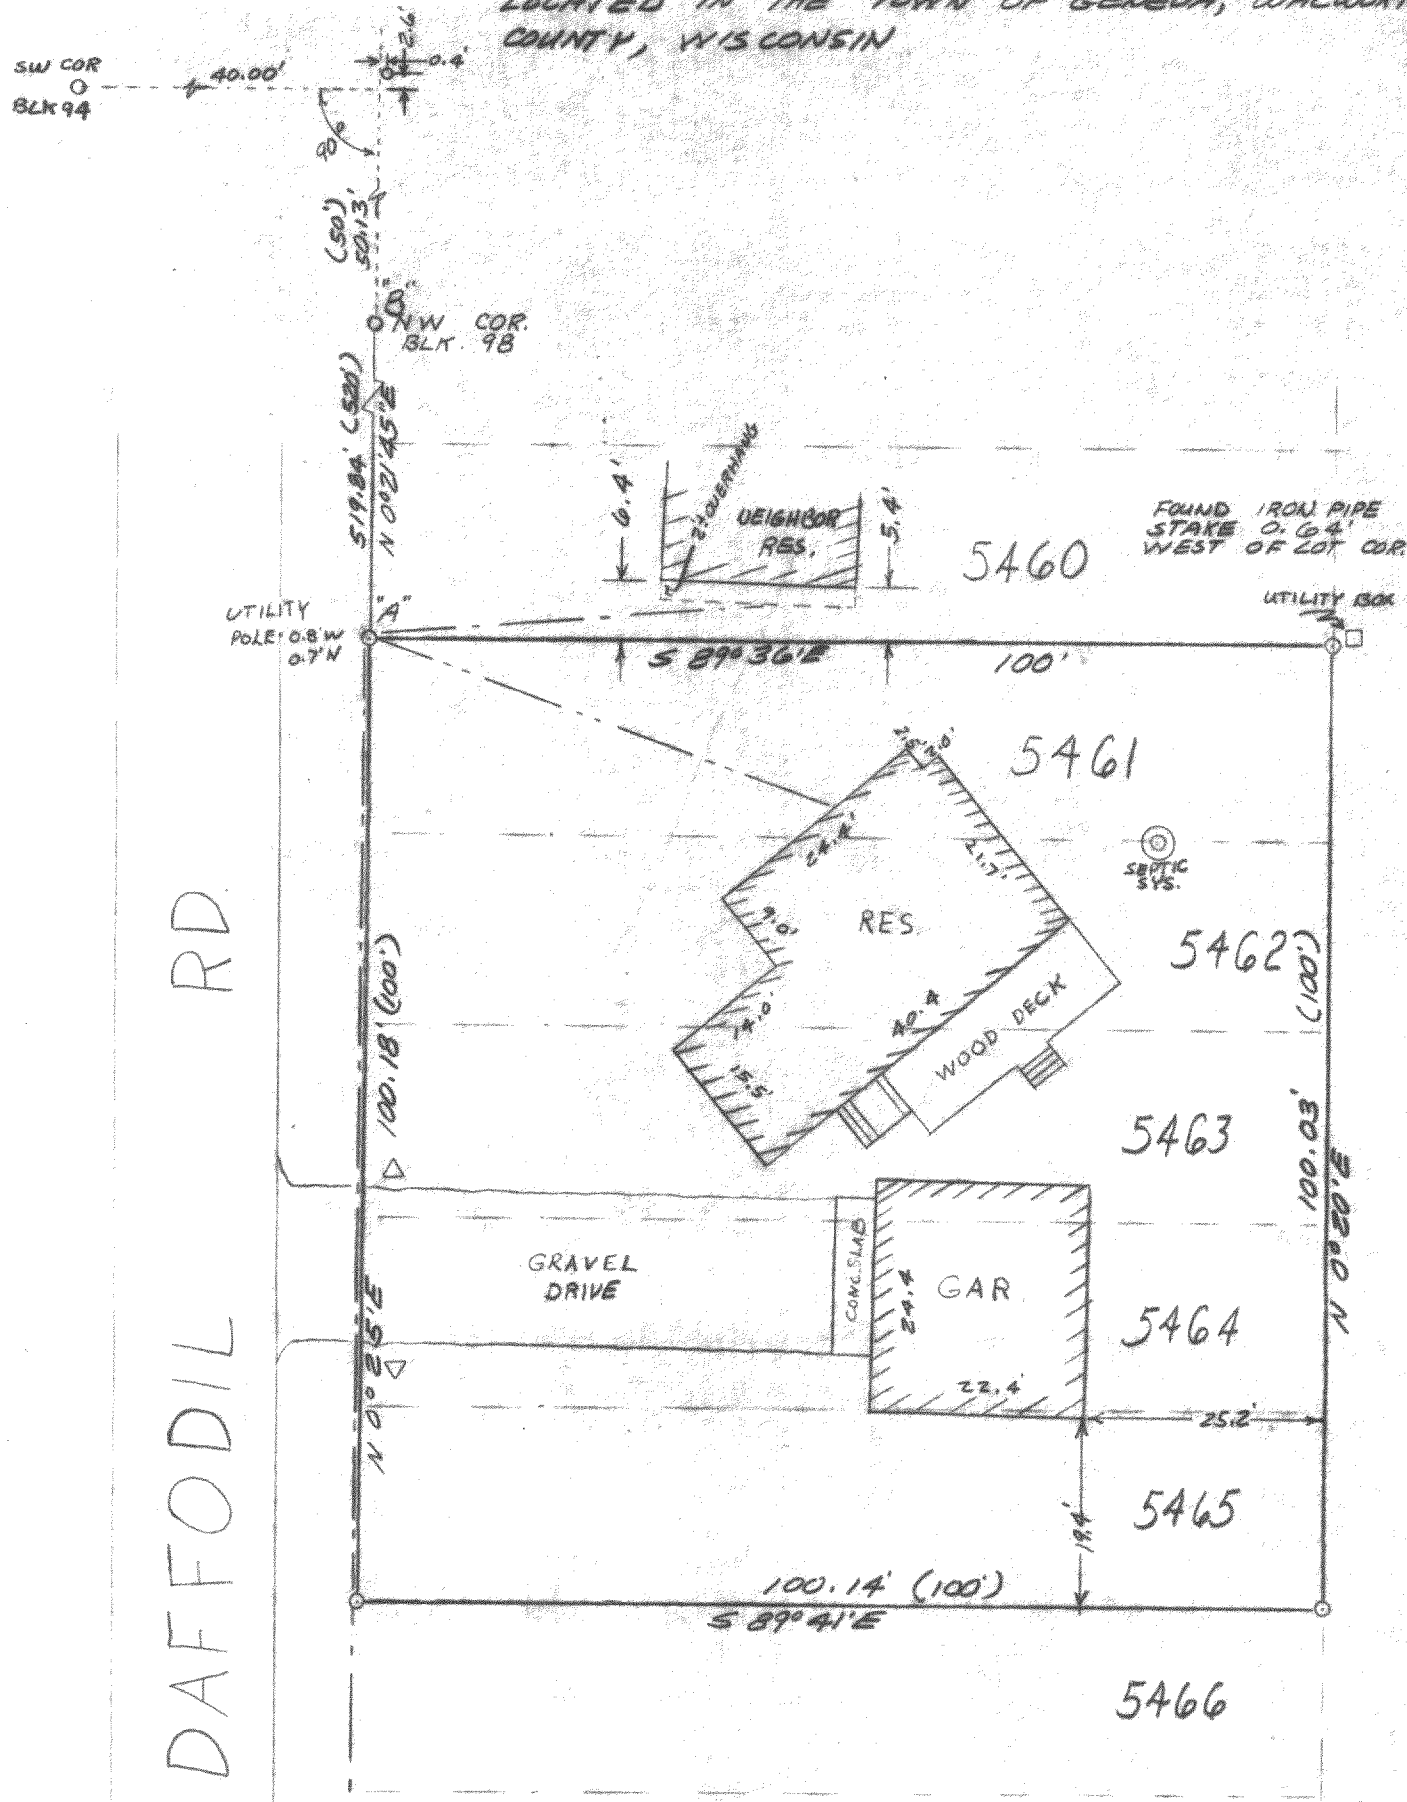

I hereby certify that I have surveyed the above described property and that the above map is a true representation thereof and shows the size and location of all buildings thereon, boundary fences, apparent easements, roadways and visible encroachments, if any. This survey is made for the use of the present owners of the property, and also those who purchase, mortgage, or guarantee the title thereto within one (1) year from the date hereof.


SCALE: 1"=20'
LEGEND

- FOUND IRON PIPE
- △ YARD LIGHT
- FOUND IRON ROD
- OVERHEAD WIRES
- UNDERGROUND WIRES
- (XXY) RECORD DIMENSION

Robert A. Farris
DATED 5 NOV. 1984

FARRIS, HANSEN & ASSOCIATES, INC.
715 W. Walworth St. P.O. Box 487
Elkhorn, WI 53121

WORK ORDERED BY MIKAUT REALTY
FOR LARRY BORIK

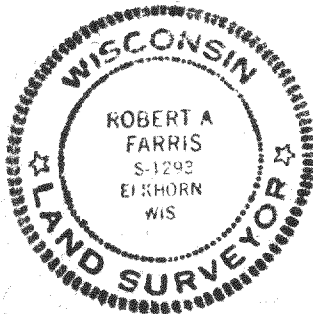

PROJ # 2330