

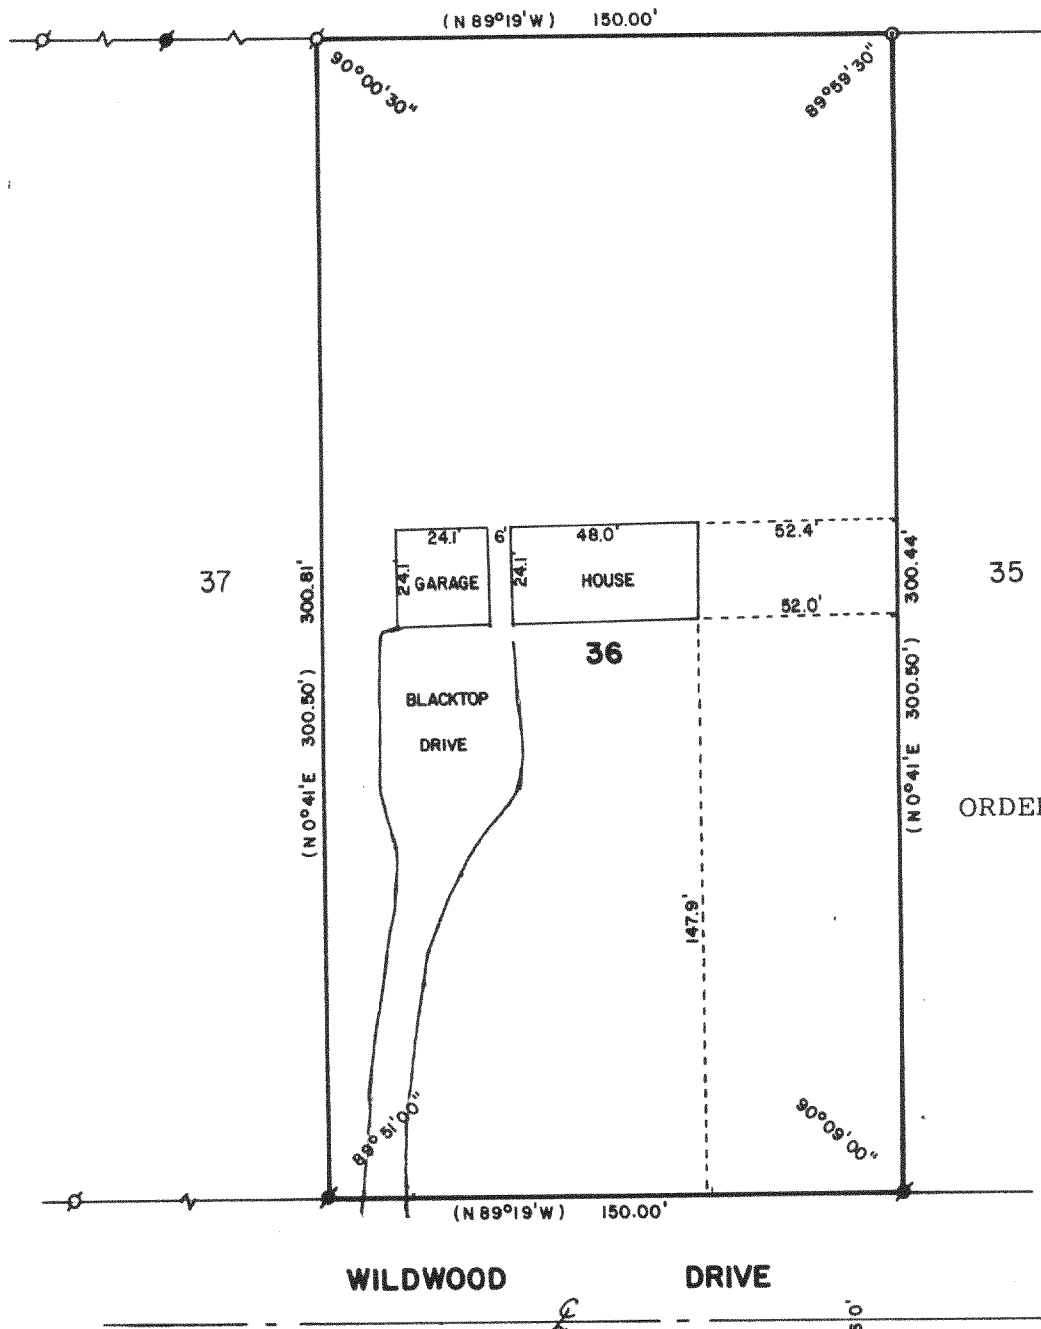


WALWORTH COUNTY
SURVEYING & MAPPING
LAKE GENEVA, WISCONSIN

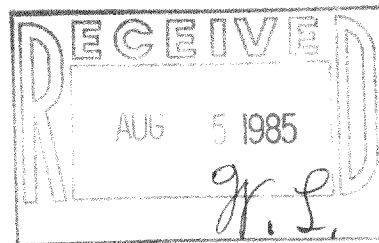

ORDERED BY: STURG TAGGART
AGENCY
736 MAIN ST.
LAKE GENEVA,
WI 53147

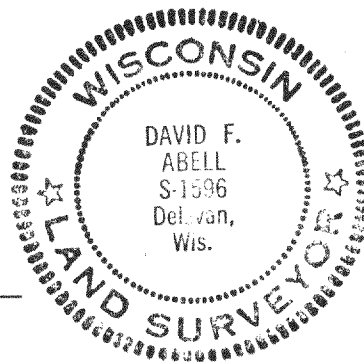

PLAT OF SURVEY OF

LOT 36 OF WILDWOOD SUBDIVISION LOCATED IN
THE NORTHWEST 1/4 AND NORTHEAST 1/4 OF
SECTION 34, TOWN 2 NORTH, RANGE 17 EAST,
WALWORTH COUNTY, WISCONSIN.



SCALE - 1"=50'

LEGEND

- ⚡ - IRON PIPE FOUND
- - IRON PIPE SET
- ⚡ - IRON ROD FOUND
- () - RECORDED AS

I, DAVID F. ABELL, DO HEREBY CERTIFY
THAT I HAVE SURVEYED THE PROPERTY
HEREON DESCRIBED ACCORDING TO THE
OFFICIAL RECORDS, AND THAT THE PLAT
HEREON IS A CORRECT REPRESENTATION
OF THE PROPERTY LINES TO THE BEST OF
MY KNOWLEDGE AND BELIEF.

David F. Abell

DAVID F. ABELL
WISCONSIN REGISTERED LAND SURVEYOR, S-1596

May 23, 1985

DATE

JOB NUMBER 0276

217-611-BV