


PLAT OF SURVEY

LOTS 5867 through 5877 both inclusive and LOTS 5900 through 5905 both inclusive
of BLOCK 104 of LAKE COMO BEACH SUBDIVISION, TOWN OF GENEVA, WALWORTH COUNTY,
WISCONSIN.

Surveyed for - Dana Montana Surveyed by - Abernathy and Associates
Rt. 3 Box 273
Elkhorn, Wi. 53121
723-4260

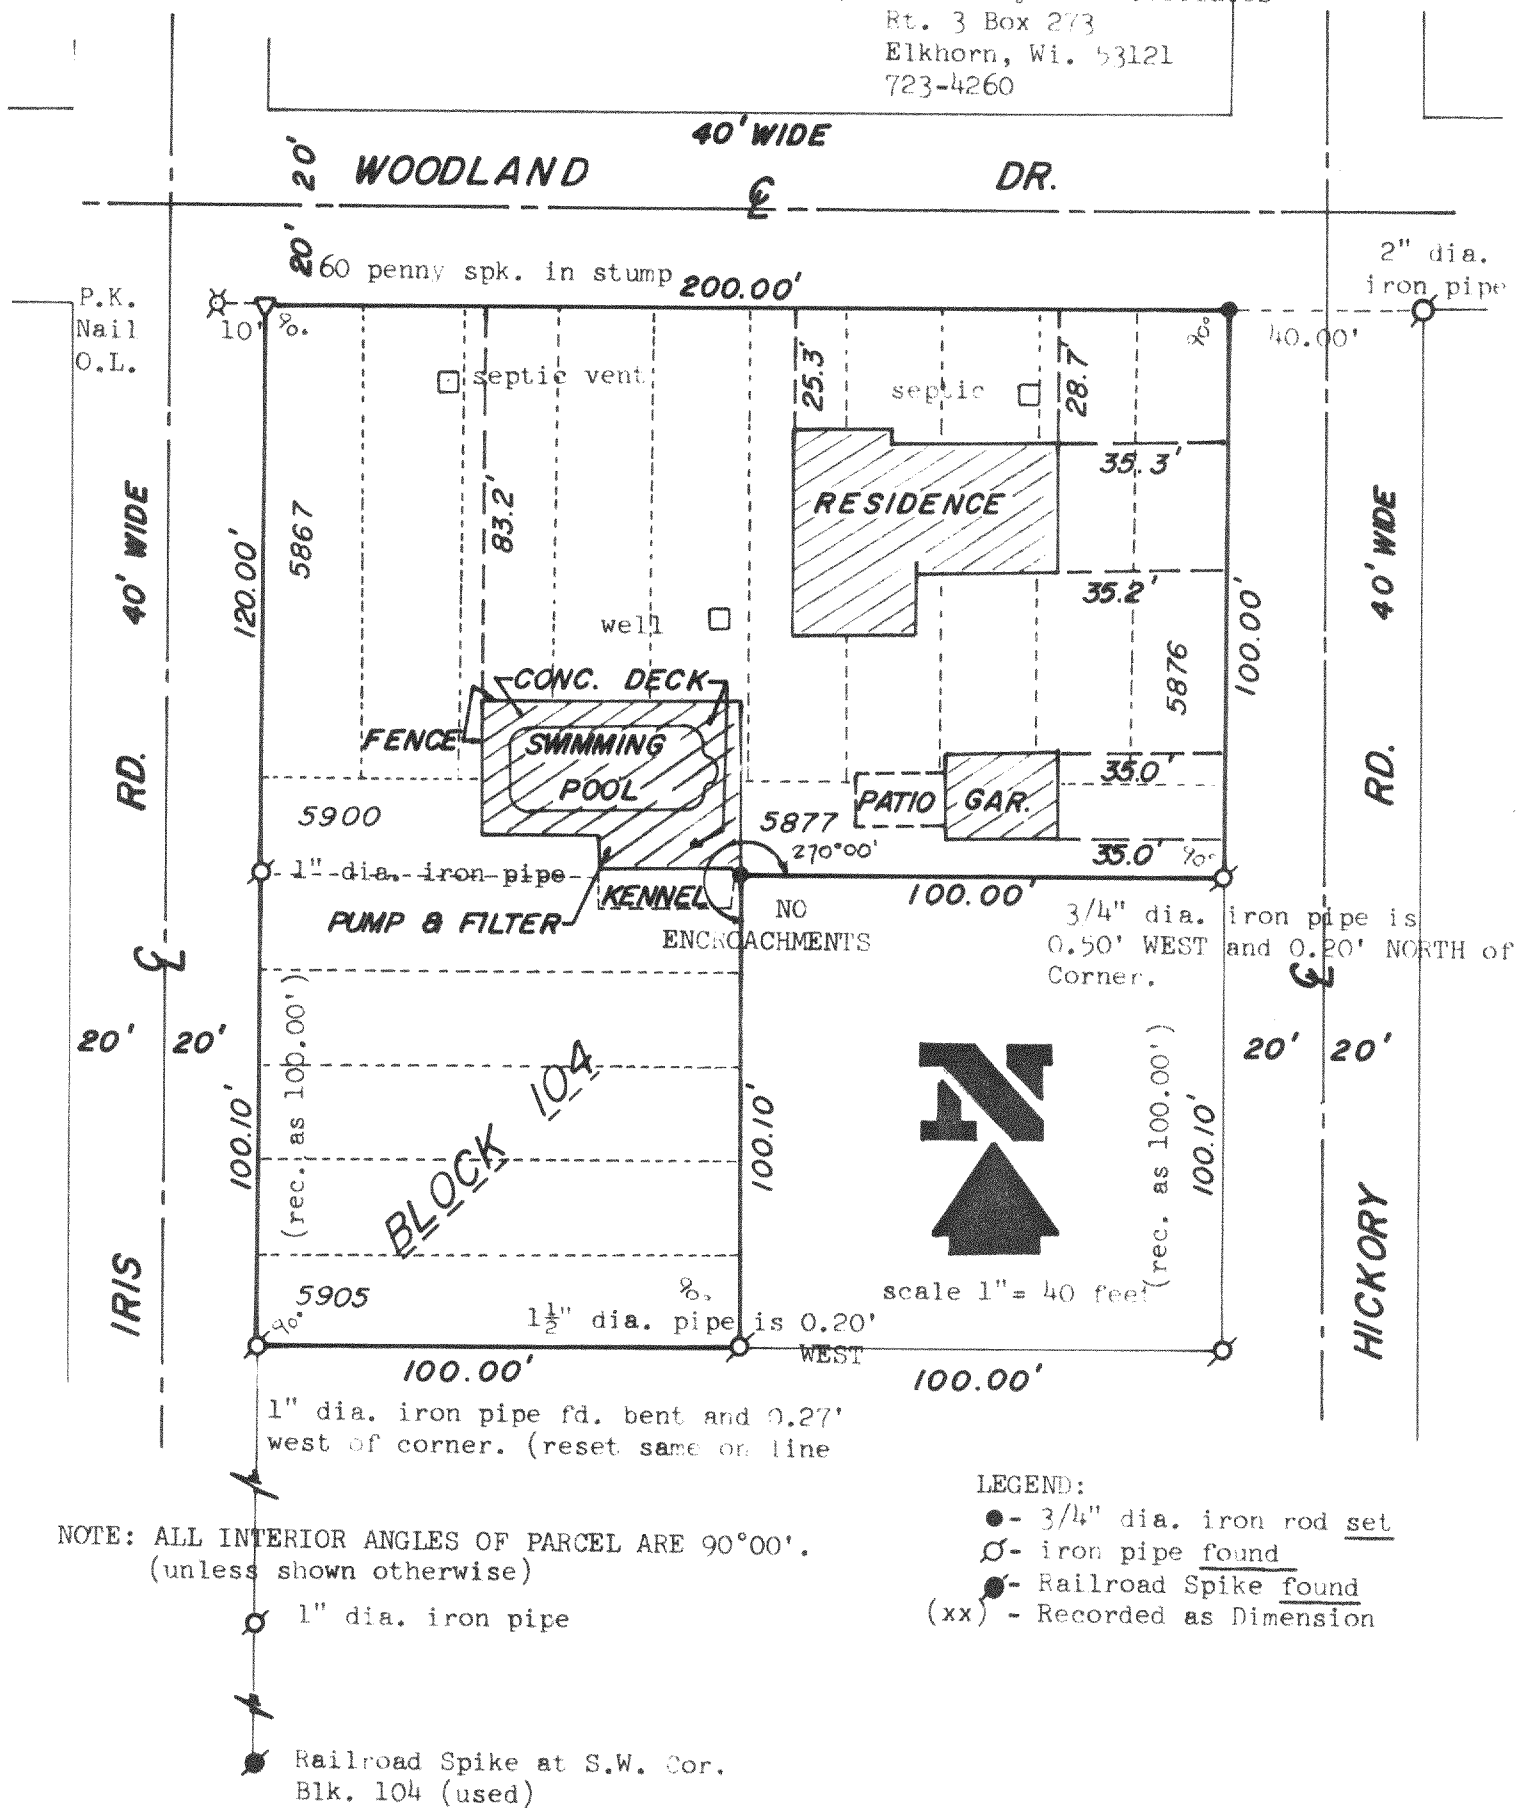


NOTE: ALL INTERIOR ANGLES OF PARCEL ARE 90°00'.
(unless shown otherwise)

LEGEND:

- - 3/4" dia. iron rod set
- - iron pipe found
- - Railroad Spike found
- (xx) - Recorded as Dimension

I, Kenneth B. Abernathy, do hereby certify that I have surveyed the above described property, that the plat hereon is an accurate survey, a true representation thereof, correctly shows the exterior boundaries, and the correct measurements thereof, and the improvements thereon, to the best of my professional knowledge and belief.

Dated this 22 day of November 1984

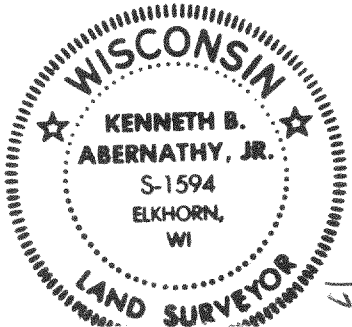

Kenneth B. Abernathy Jr.
Kenneth B. Abernathy Jr. S-1594
Abernathy and Associates

JLCB-1201

217-612 1984.1103