



WALWORTH COUNTY  
SURVEYING & MAPPING  
LAKE GENEVA, WISCONSIN

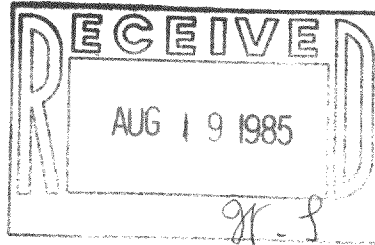

OLIVE ROAD 40'

ROAD

PALMER

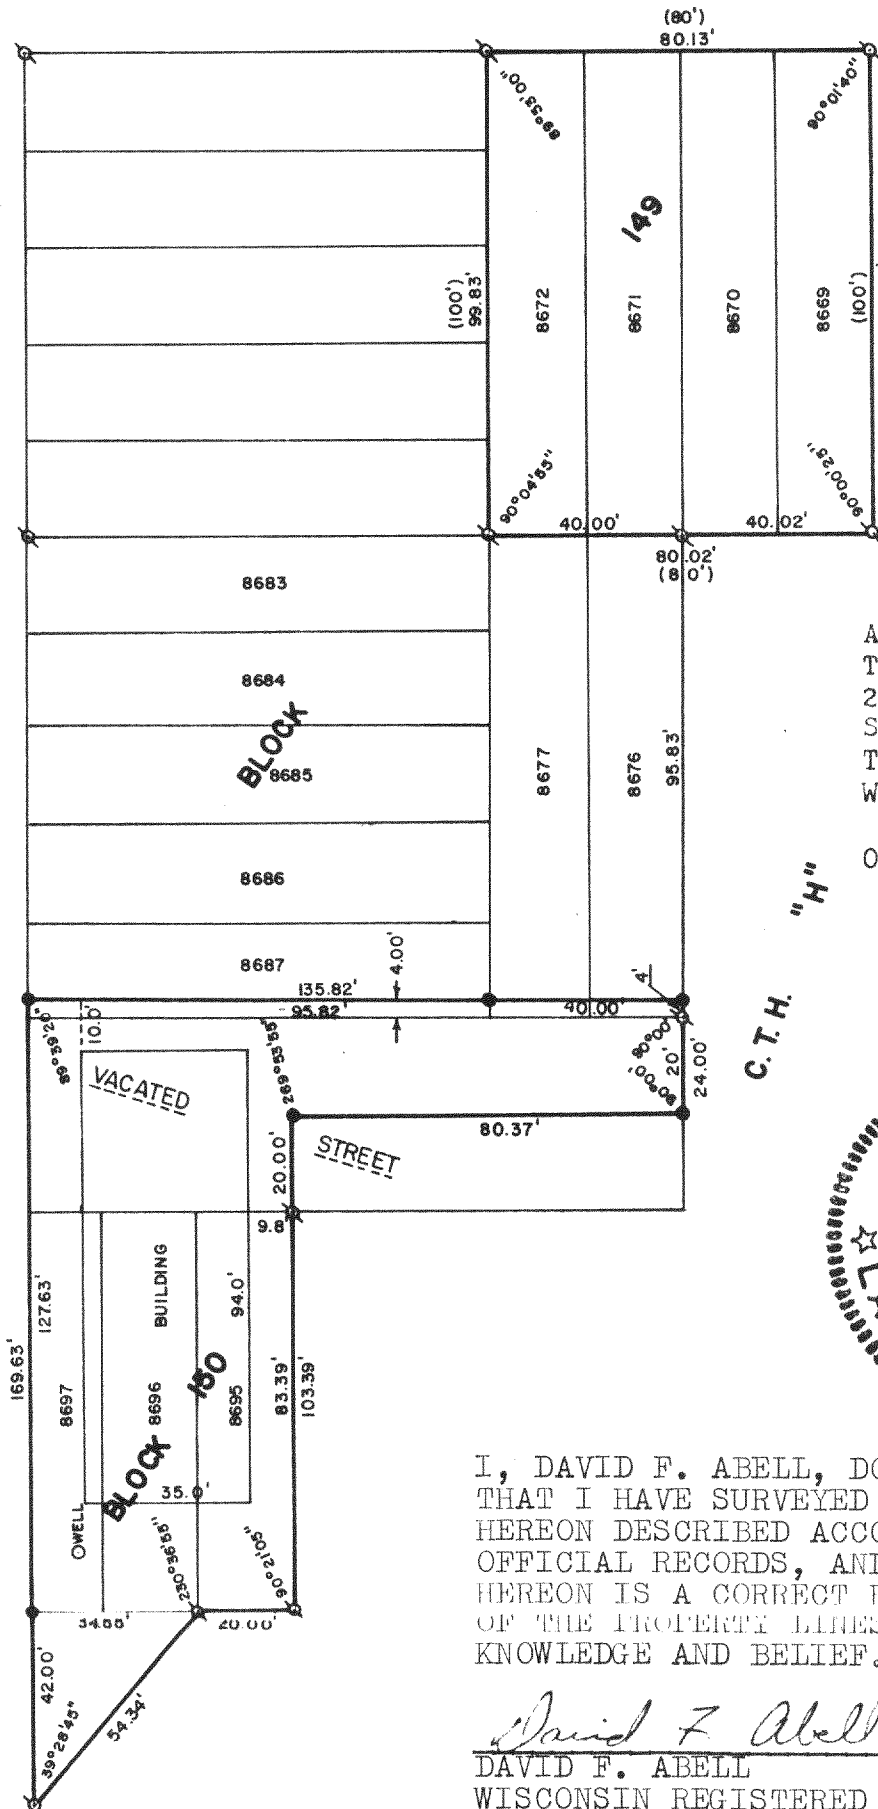

SCALE - 1"=40'

LEGEND

- IRON PIPE FOUND
- IRON ROD SET
- ( ) RECORDED AS

PLAT OF SURVEY OF

A PARCEL OF LAND LOCATED IN  
THE SOUTHEAST 1/4 OF SECTION  
21, AND ALSO LAKE COMO BEACH  
SUBDIVISION, ALL LOCATED IN  
T 2 N, R 17 E, WALWORTH COUNTY,  
WISCONSIN.

ORDERED BY:

MIKRUT REALTY  
RT. 5, BOX 453  
LAKE GENEVA, WISCONSIN  
53147



I, DAVID F. ABELL, DO HEREBY CERTIFY  
THAT I HAVE SURVEYED THE PROPERTY  
HEREON DESCRIBED ACCORDING TO THE  
OFFICIAL RECORDS, AND THAT THE PLAT  
HEREON IS A CORRECT REPRESENTATION  
OF THE PROPERTY LINES TO THE BEST OF MY  
KNOWLEDGE AND BELIEF.

*David F. Abell*

DAVID F. ABELL  
WISCONSIN REGISTERED LAND SURVEYOR, S-1596

DATE *August 15, 1985* JOB NUMBER - 0345

JUL 18 1894, 1860  
JUL 21-19 21/10

217-614-B