

RECEIVED
SEP 30 1985
97.5

KOLB LAND CONSULTING, INC.
LAND SURVEYING • SUBDIVIDING • LAND PLANNING


929 WILLIAMS STREET LAKE GENEVA, WISCONSIN 53147 414-248-3697



SCALE: 1" = 30'

LEGEND

- Ø - IRON PIPE FOUND
- Δ - UTILITY POLE
- OVERHEAD UTILITY LINE
- x— FENCE

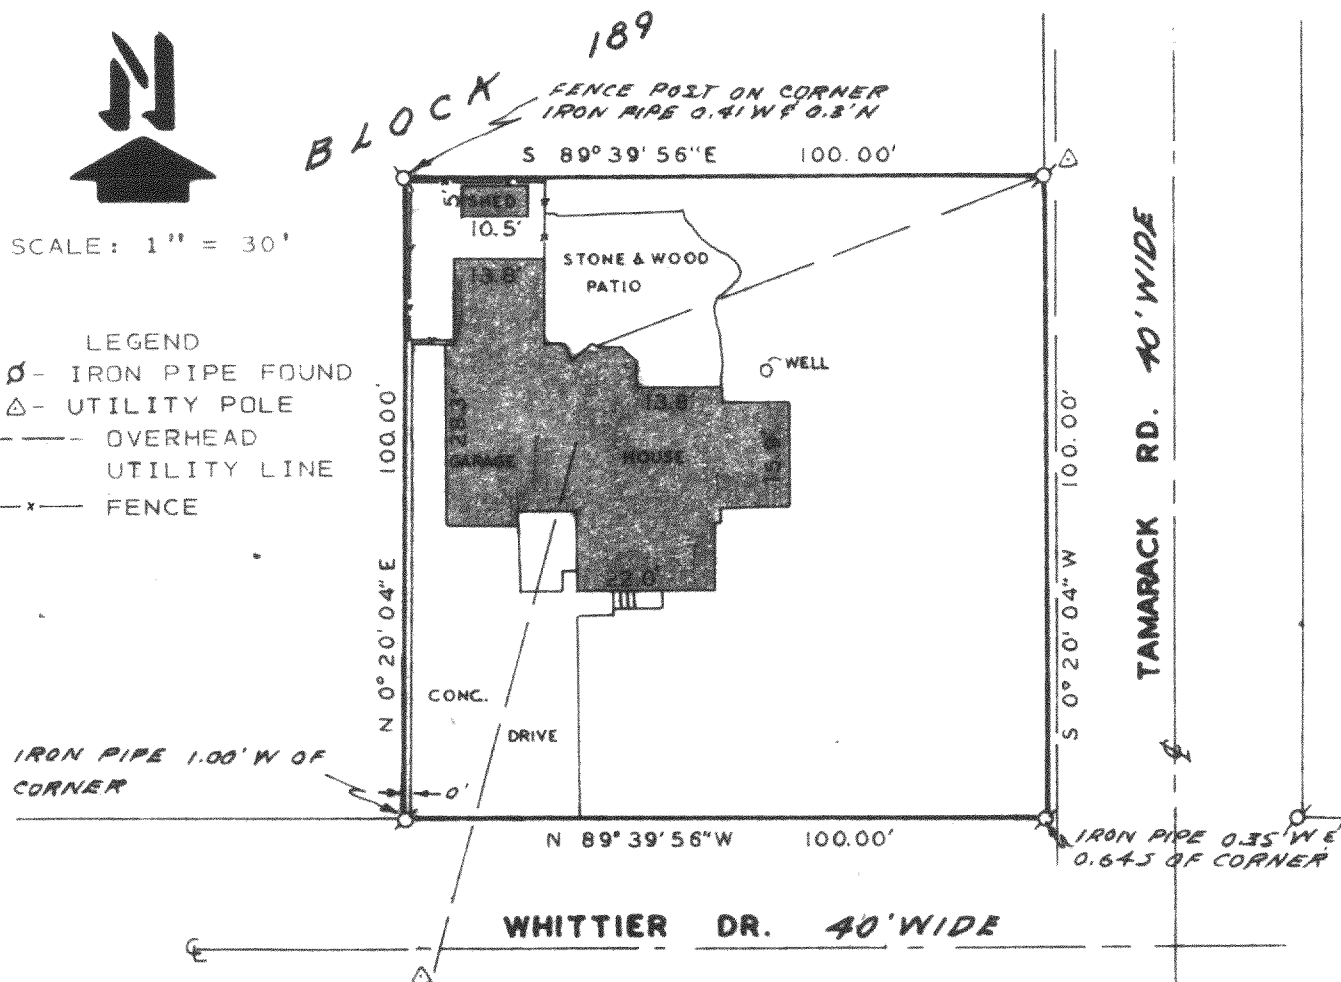

ORDERED BY:
KAREN LUBINSKY, AN OWNER
RT.2, BOX 530-26
LAKE GENEVA, WI. 53147


PLAT OF SURVEY OF
LOTS 10388-10392, BLOCK 189,
LAKE COMO BEACH, T2N, R17E, TOWN
OF GENEVA, WALWORTH COUNTY, WISCON-
SIN.

NOTE: BEARINGS ARE ASSUMED
AS SHOWN ON THE RECORDED
PLAT OF LAKE COMO BEACH.

I HEREBY CERTIFY THAT I HAVE SURVEYED THE ABOVE
DESCRIBED PROPERTY AND THAT THE ABOVE MAP IS A
TRUE REPRESENTATION THEREOF AND SHOWS THE SIZE
AND LOCATION OF THE PROPERTY, ITS EXTERIOR BOUN-
DARIES, THE LOCATION OF ALL VISIBLE STRUCTURES
AND DIMENSIONS OF ALL PRINCIPAL BUILDINGS THEREON,
BOUNDARY FENCES, APPARENT EASEMENTS, ROADWAYS
AND VISIBLE ENCROACHMENTS, IF ANY, TO THE BEST
OF MY KNOWLEDGE AND BELIEF. THIS SURVEY IS MADE
FOR THE USE OF THE PRESENT OWNERS OF THE PROPERTY,
AND ALSO THOSE WHO PURCHASE, MORTGAGE, OR GUAR-
ANTEE THE TITLE THERETO WITHIN ONE (1) YEAR FROM
DATE HEREOF.

Harold H. Kolb
HAROLD H. KOLB

WISCONSIN REGISTERED LAND SURVEYOR, S-187
DATE JUNE 14, 1985
REVISED _____
REVISED _____

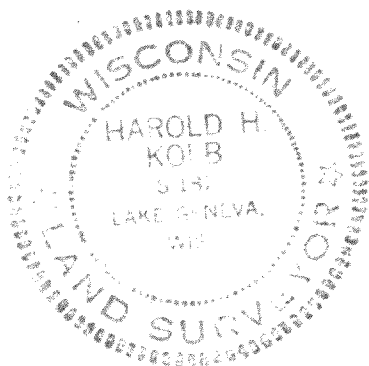

JLCB-02250

2-17- JLCB-2250 217-616-K