


KOLB LAND CONSULTING, INC.
LAND SURVEYING • SUBDIVIDING • LAND PLANNING

LAKE GENEVA, WISCONSIN 53147

WALWORTH COUNTY, WISCONSIN 53115

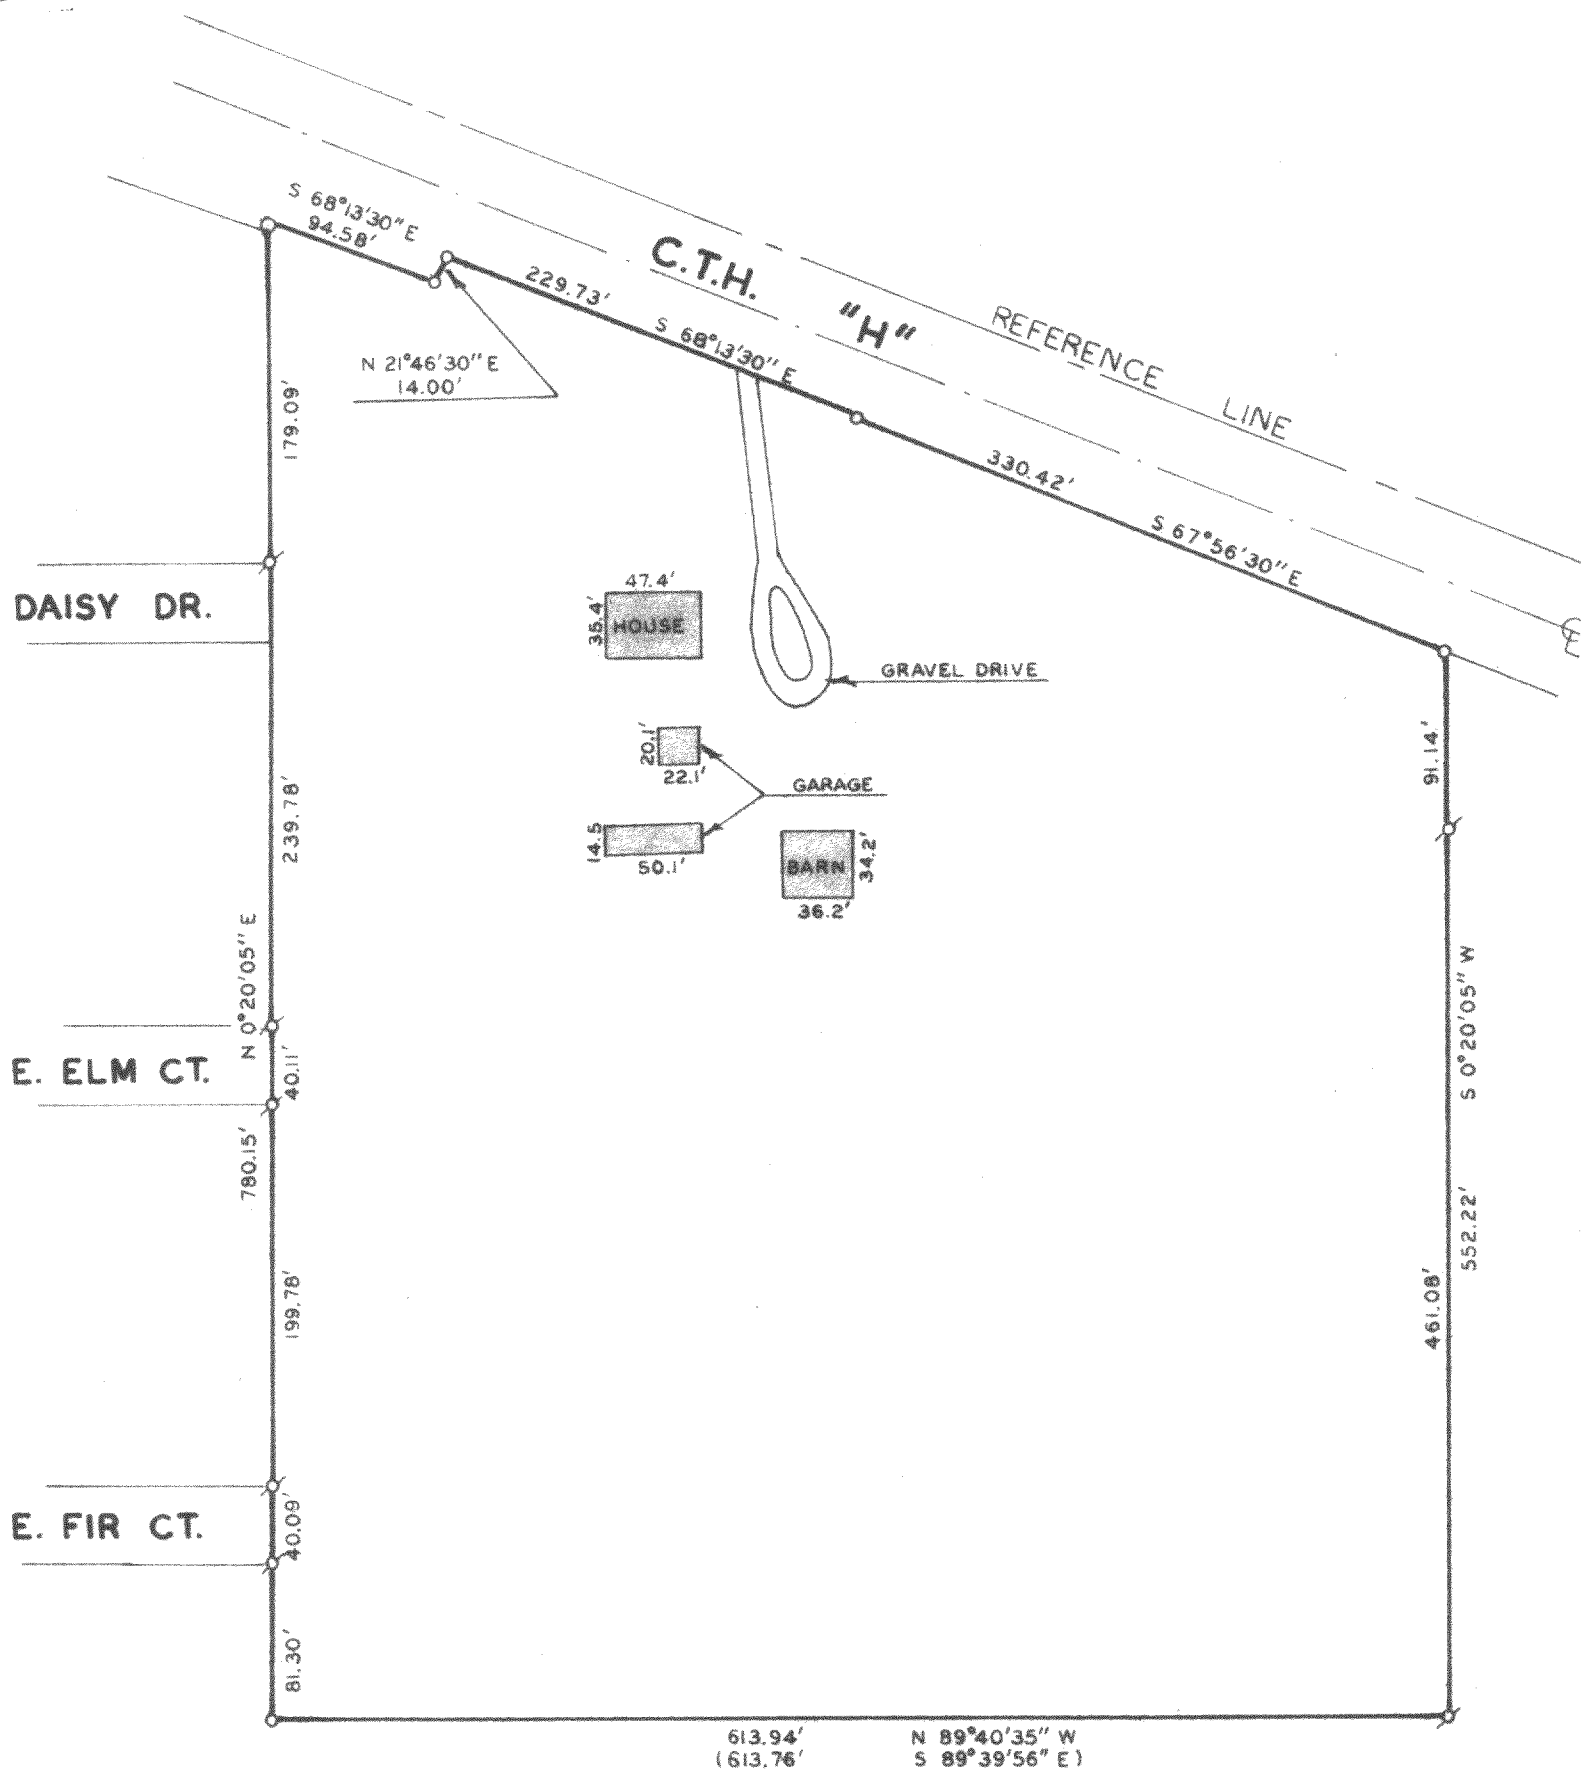

PLAT OF SURVEY OF

A PARCEL OF LAND LOCATED IN THE SOUTHWEST CORNER OF SECTION 22,
T 2 N, R 17 E, TOWN OF GENEVA, WALWORTH COUNTY, WISCONSIN.

OWNER: THOMAS MC DONOUGH
RT. 5, BOX 457
LAKE GENEVA, WI 53147


ORDERED BY: ANCHOR SAVINGS & LOAN
500 E. WALWORTH AVE
DELAVER, WI 53115



SCALE - 1" = 100'

LEGEND

- ⊗ IRON PIPE FOUND
- IRON PIPE SET
- () RECORDED AS

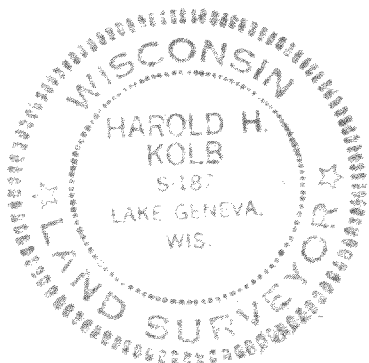

I, HAROLD H. KOLB, DO HEREBY CERTIFY
THAT I HAVE SURVEYED THE PROPERTY
HEREON DESCRIBED ACCORDING TO THE
OFFICIAL RECORDS, AND THAT THE PLAT
HEREON IS A CORRECT REPRESENTATION
OF THE LOT LINES TO THE BEST OF MY
KNOWLEDGE AND BELIEF.

Harold H. Kolb

HAROLD H. KOLB

WISCONSIN REGISTERED LAND SURVEYOR, S-187

DATE MARCH 28, 1985

REVISED: APRIL 19, 1985

G-22-12

217-619