

PLAT OF SURVEY



Legal Description: Lots 1 thru 5 Block 22, Sunset Hills Sub.. Located in the SW ¼ of Section 33, T2N R17E, Walworth County, Wis.

I hereby certify that I have surveyed the above described property and that the plat shown hereon is an accurate survey, a true representation thereof, correctly shows the exterior boundary lines, all divisions thereof, on said property and the correct measurements thereof and buildings Thereon.

Dated Dec. 19, 1984


Thomas P.A. Jensen

Thomas P.A. Jensen S-1084
Jensen Surveying & Mapping
Elkhorn, Wis. 53121

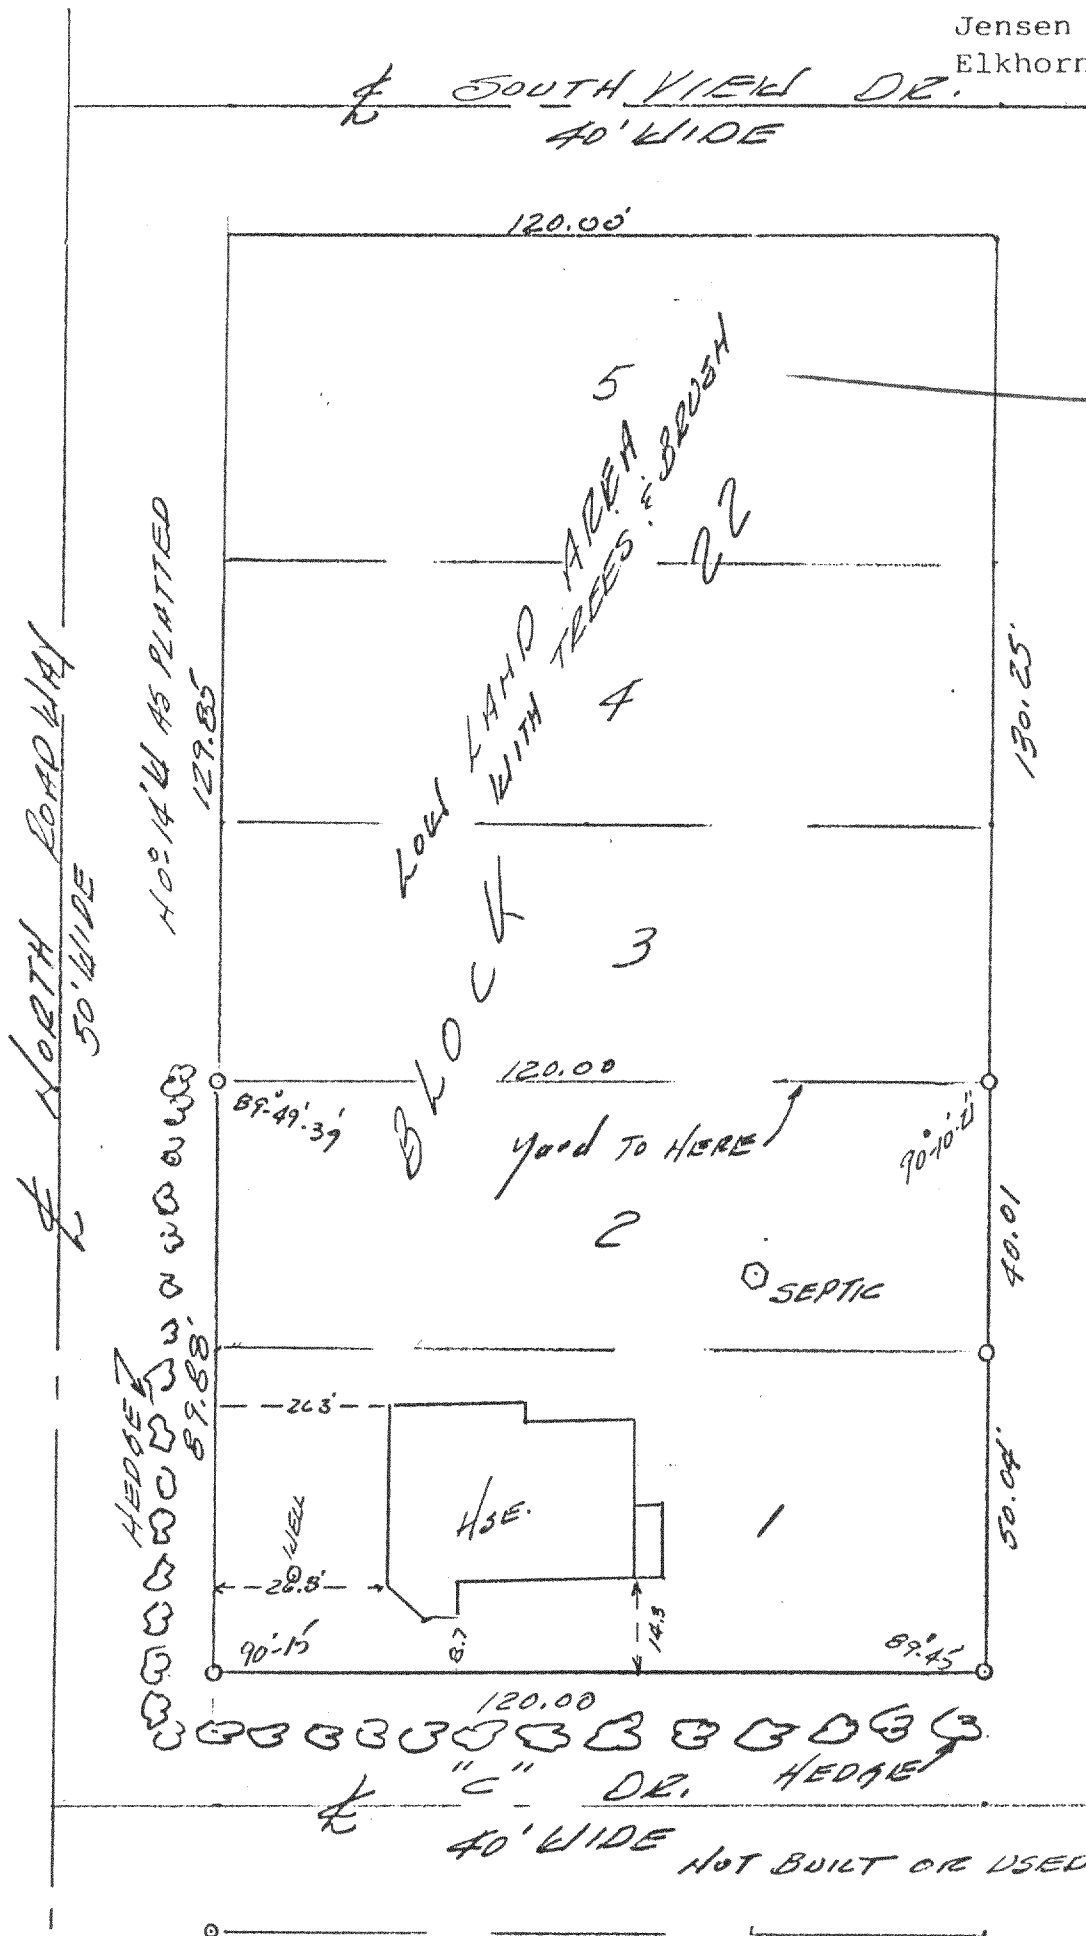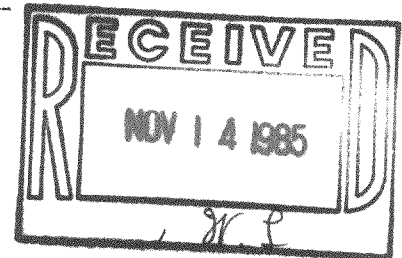

SCALE 1"=30'

○ ~ IRON PIPE FOUND
SURVEYED FOR:
MR. BIANCHI
1501 WOODFIELD RD
202 N. SCHOMBERG ILL.
60195

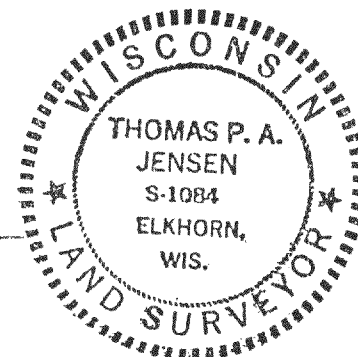

1984.077

217-620-J