




WALWORTH COUNTY
SURVEYING & MAPPING
LAKE GENEVA, WISCONSIN

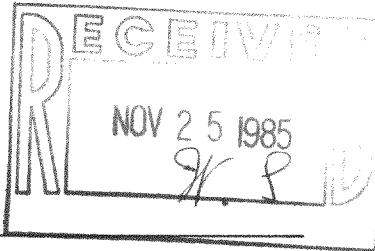

WOODLAND DRIVE

URANUS ROAD


20' 20'

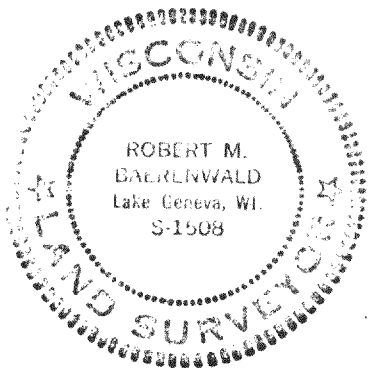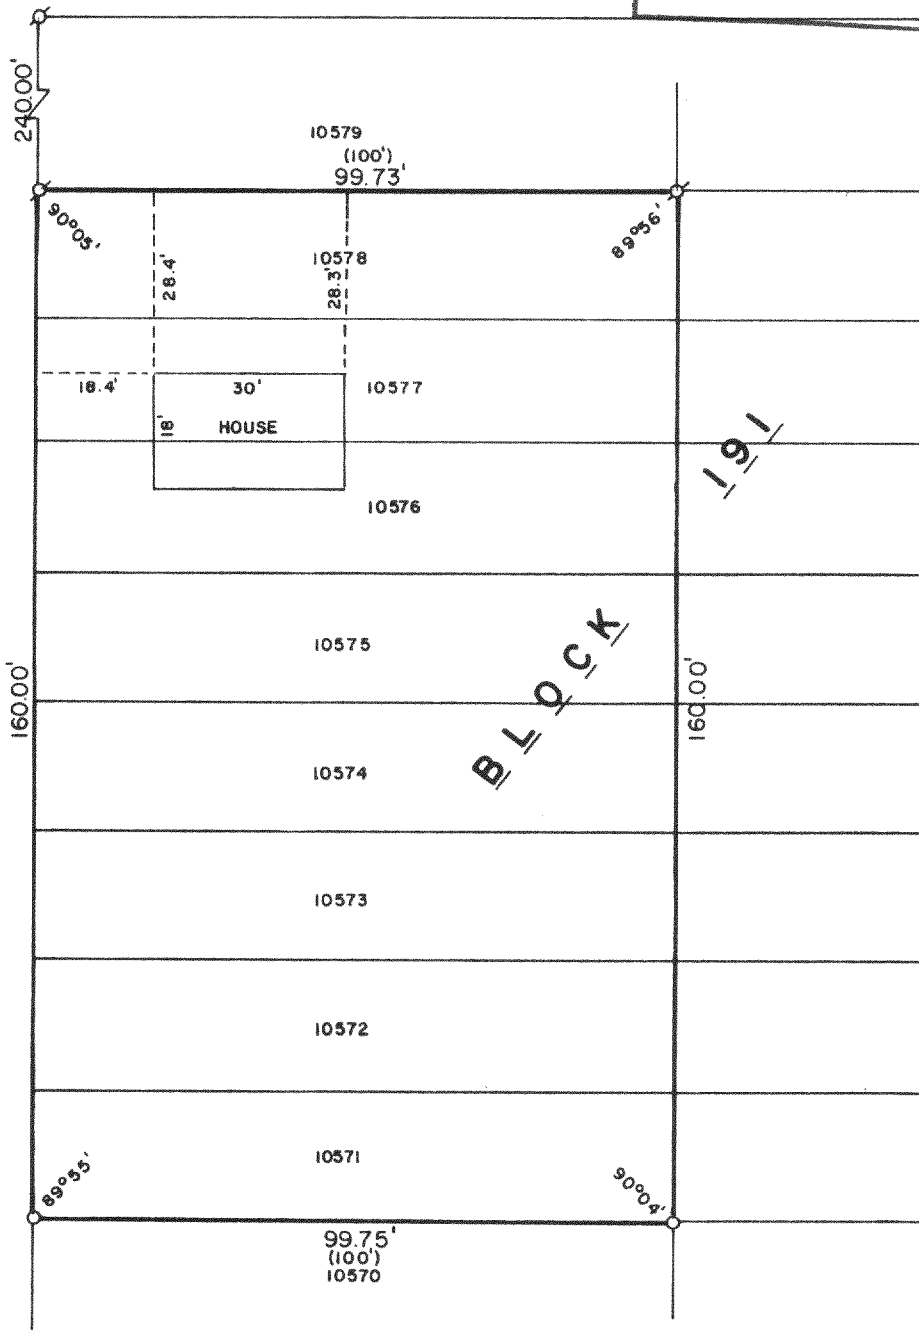

PLAT OF SURVEY OF

LOTS 10571-10578, INCLUSIVE, BLOCK 191 OF
LAKE COMO BEACH SUBDIVISION, LOCATED IN
T 2 N, R 17 E, WALWORTH COUNTY, WISCONSIN.

ORDERED BY: FRED SAMUELSON
5222 SUFFIELD COURT
SKOKIE, ILLINOIS 60077

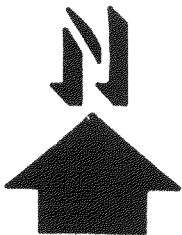

SCALE: 1"=30'

⊗ - IRON PIPE FOUND
○ - IRON ROD SET
() - RECORDED AS

I, ROBERT M. BAERENWALD, DO HEREBY CERTIFY THAT I
HAVE SURVEYED THE PROPERTY HEREON DESCRIBED ACCORDING
TO THE OFFICIAL RECORDS AND THAT THE PLAT HEREON IS A
CORRECT REPRESENTATION OF THE PROPERTY LINES TO THE
BEST OF MY KNOWLEDGE AND BELIEF.

Robert M. Baerenwald
ROBERT M. BAERENWALD
WISCONSIN REGISTERED LAND SURVEYOR, S-1508

Nov. 9, 1985
DATE JOB NO. 0398

217-622-B