
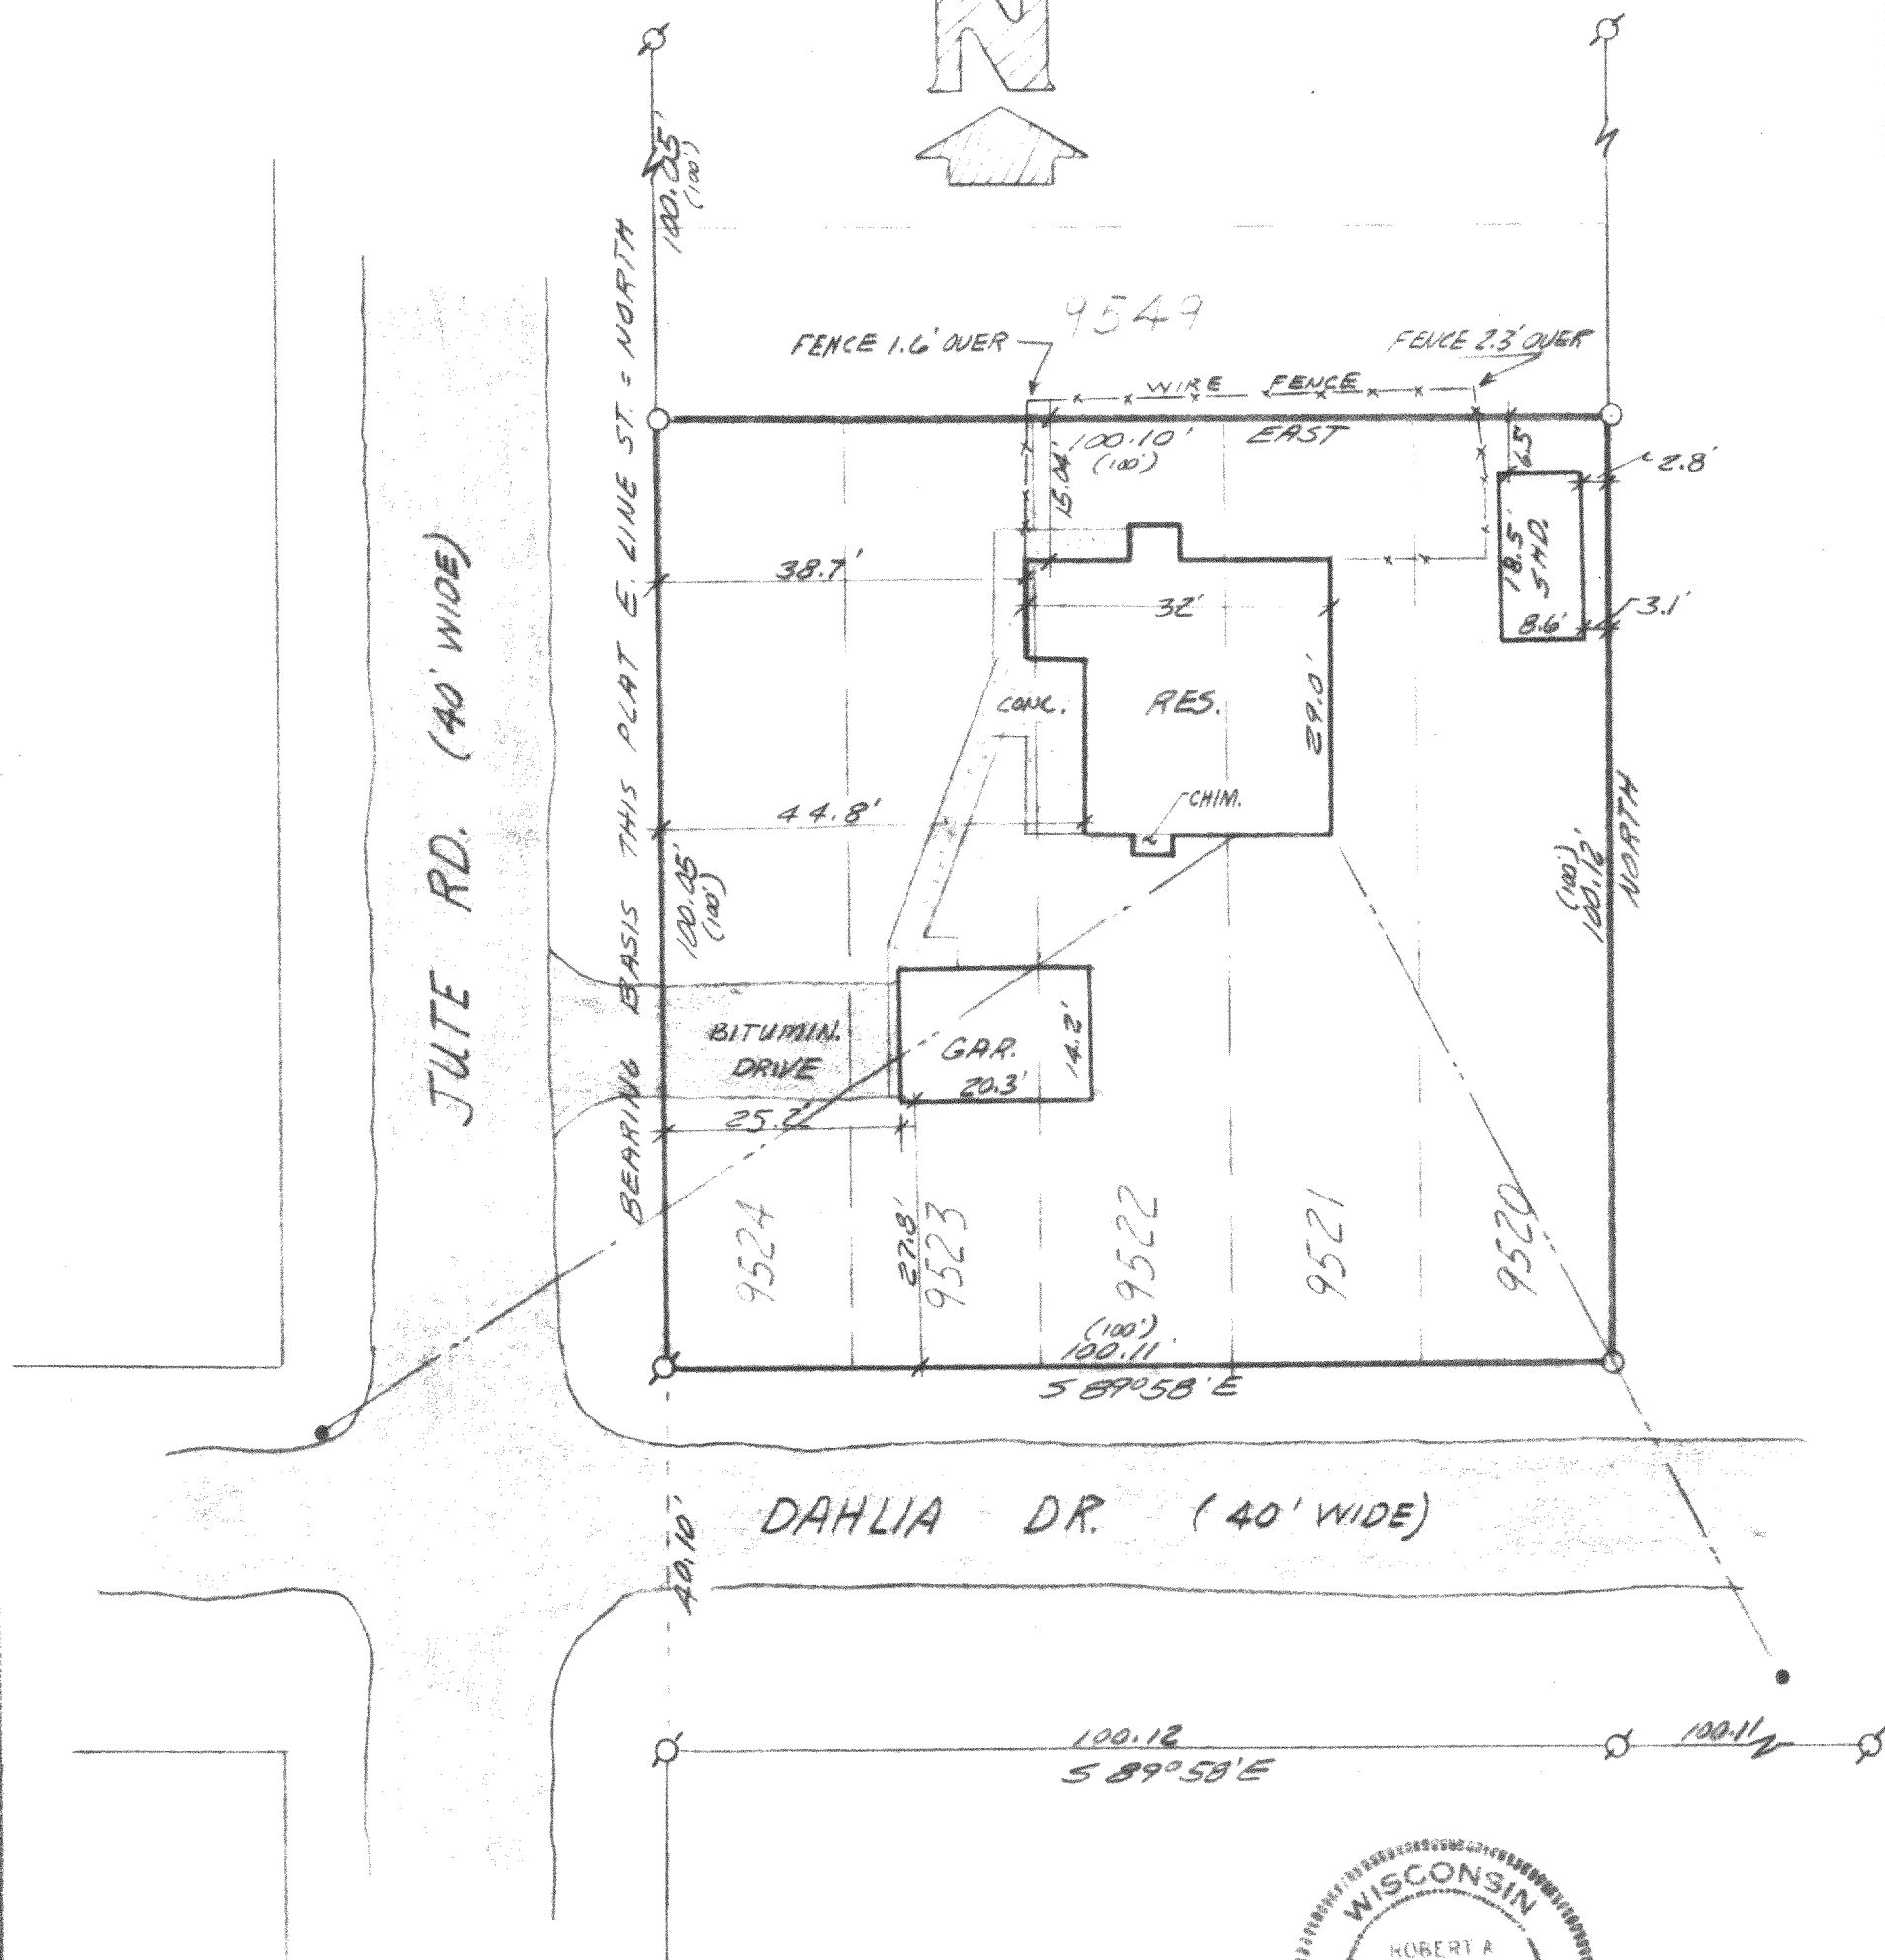


PLAT OF SURVEY LOTS 9520, 9521, 9522, 9523, & 9524 OF
BLOCK 172 OF LAKE COMO BEACH SUBDIVISION, TOWN
OF GENEVA, WALWORTH COUNTY, WISCONSIN

WORK ORDERED BY CARMIN REALTORS FOR EDNA KUTSCHEROUSKY

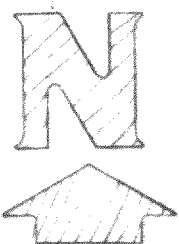


10 0 10 20 30 40 50 60 70 80 90 100

MAP SCALE IN FEET

Legend

- = IRON PIPE SURVEY STAKE FOUND
- = 1" x 24" IRON PIPE STAKE SET
- (XXX) = RECORD DIMENSION
- = UTILITY POLE & OVERHEAD WIRES

I hereby certify that I have surveyed the above described property and that the above map is a true representation thereof and shows the size and location of the property, its exterior boundaries, the location of all visible structures and dimensions of all principal buildings thereon, boundary fences, apparent easements, roadways and visible encroachments, if any.
This survey is made for the use of the present owners of the property, and also those who purchase, mortgage, or guarantee the title thereto within one (1) year from date hereof.

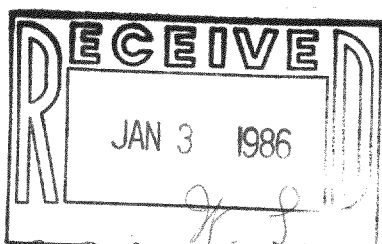

Robert A. Farris
DATED 12/20/85

PROJ. # 2523

217-625-F