


WALWORTH COUNTY
SURVEYING & MAPPING
LAKE GENEVA, WISCONSIN

FOUND IRON ROD 0.3' WEST OF
LOT CORNER - FENCE POST AT
LOT CORNER

B
L
O
C
K
9
9

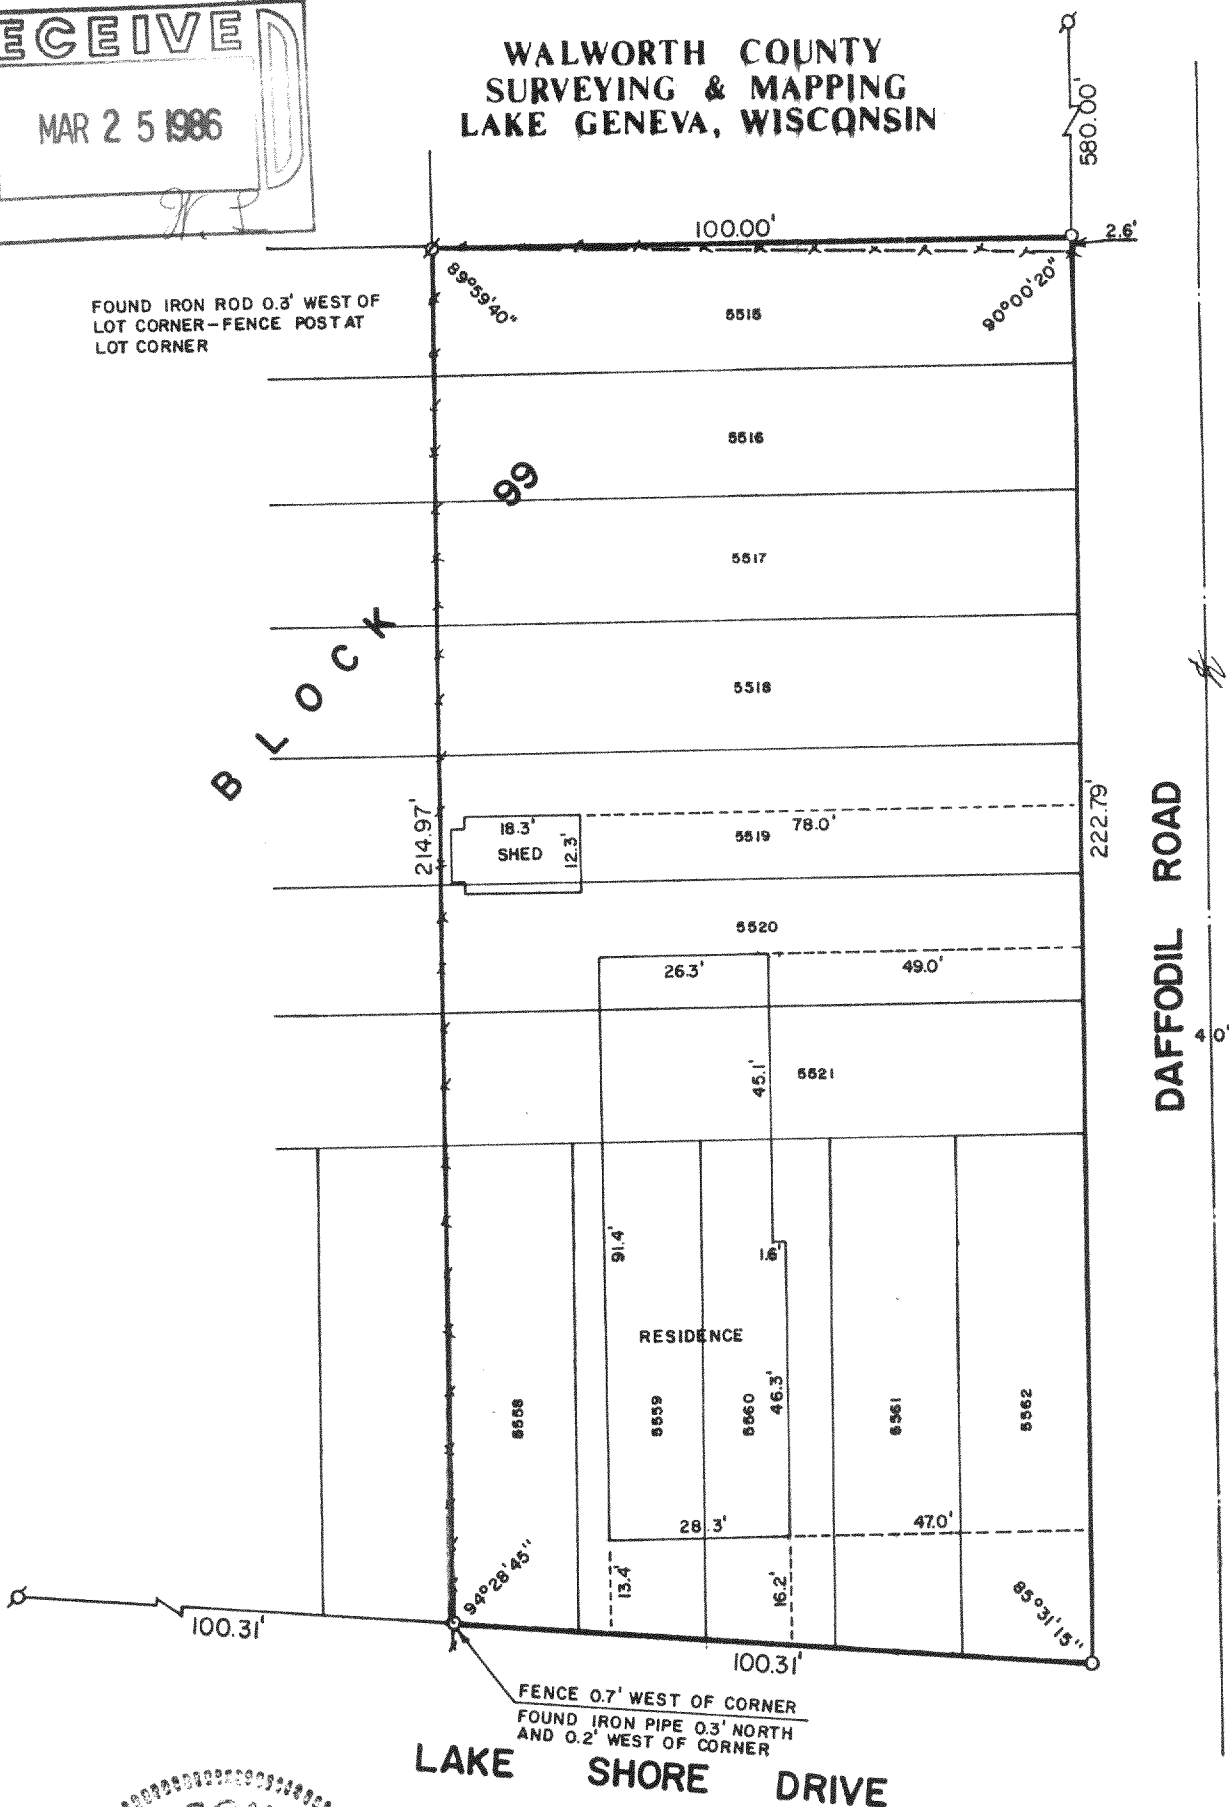

LAKE SHORE DRIVE

DAFFODIL ROAD

PLAT OF SURVEY OF



LOTS 5515-5521 AND 5558-5562, BLOCK 99 OF LAKE COMO
BEACH SUBDIVISION, LOCATED IN T 2 N, R 17 E,
WALWORTH COUNTY, WISCONSIN.

ORDERED BY: MIKRUT REALTY
RT. 5, BOX 453
LAKE GENEVA, WISCONSIN 53147

I, ROBERT M. BAERENWALD, DO HEREBY CERTIFY THAT I
HAVE SURVEYED THE PROPERTY HEREON DESCRIBED ACCORDING
TO THE OFFICIAL RECORDS AND THAT THE PLAT HEREON IS A
CORRECT REPRESENTATION OF THE PROPERTY LINES TO THE
BEST OF MY KNOWLEDGE AND BELIEF.

Robert M. Baerenwald
ROBERT M. BAERENWALD
WISCONSIN REGISTERED LAND SURVEYOR, S-1508

Dec. 20, 1985
DATE JOB NO. 0442

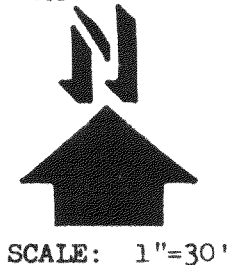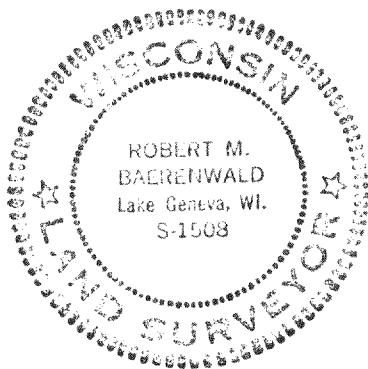

⊙ - IRON PIPE FOUND
○ - IRON ROD SET

JLCB-1118, 1130

217-6287