


50'

ROADWAY

NORTH

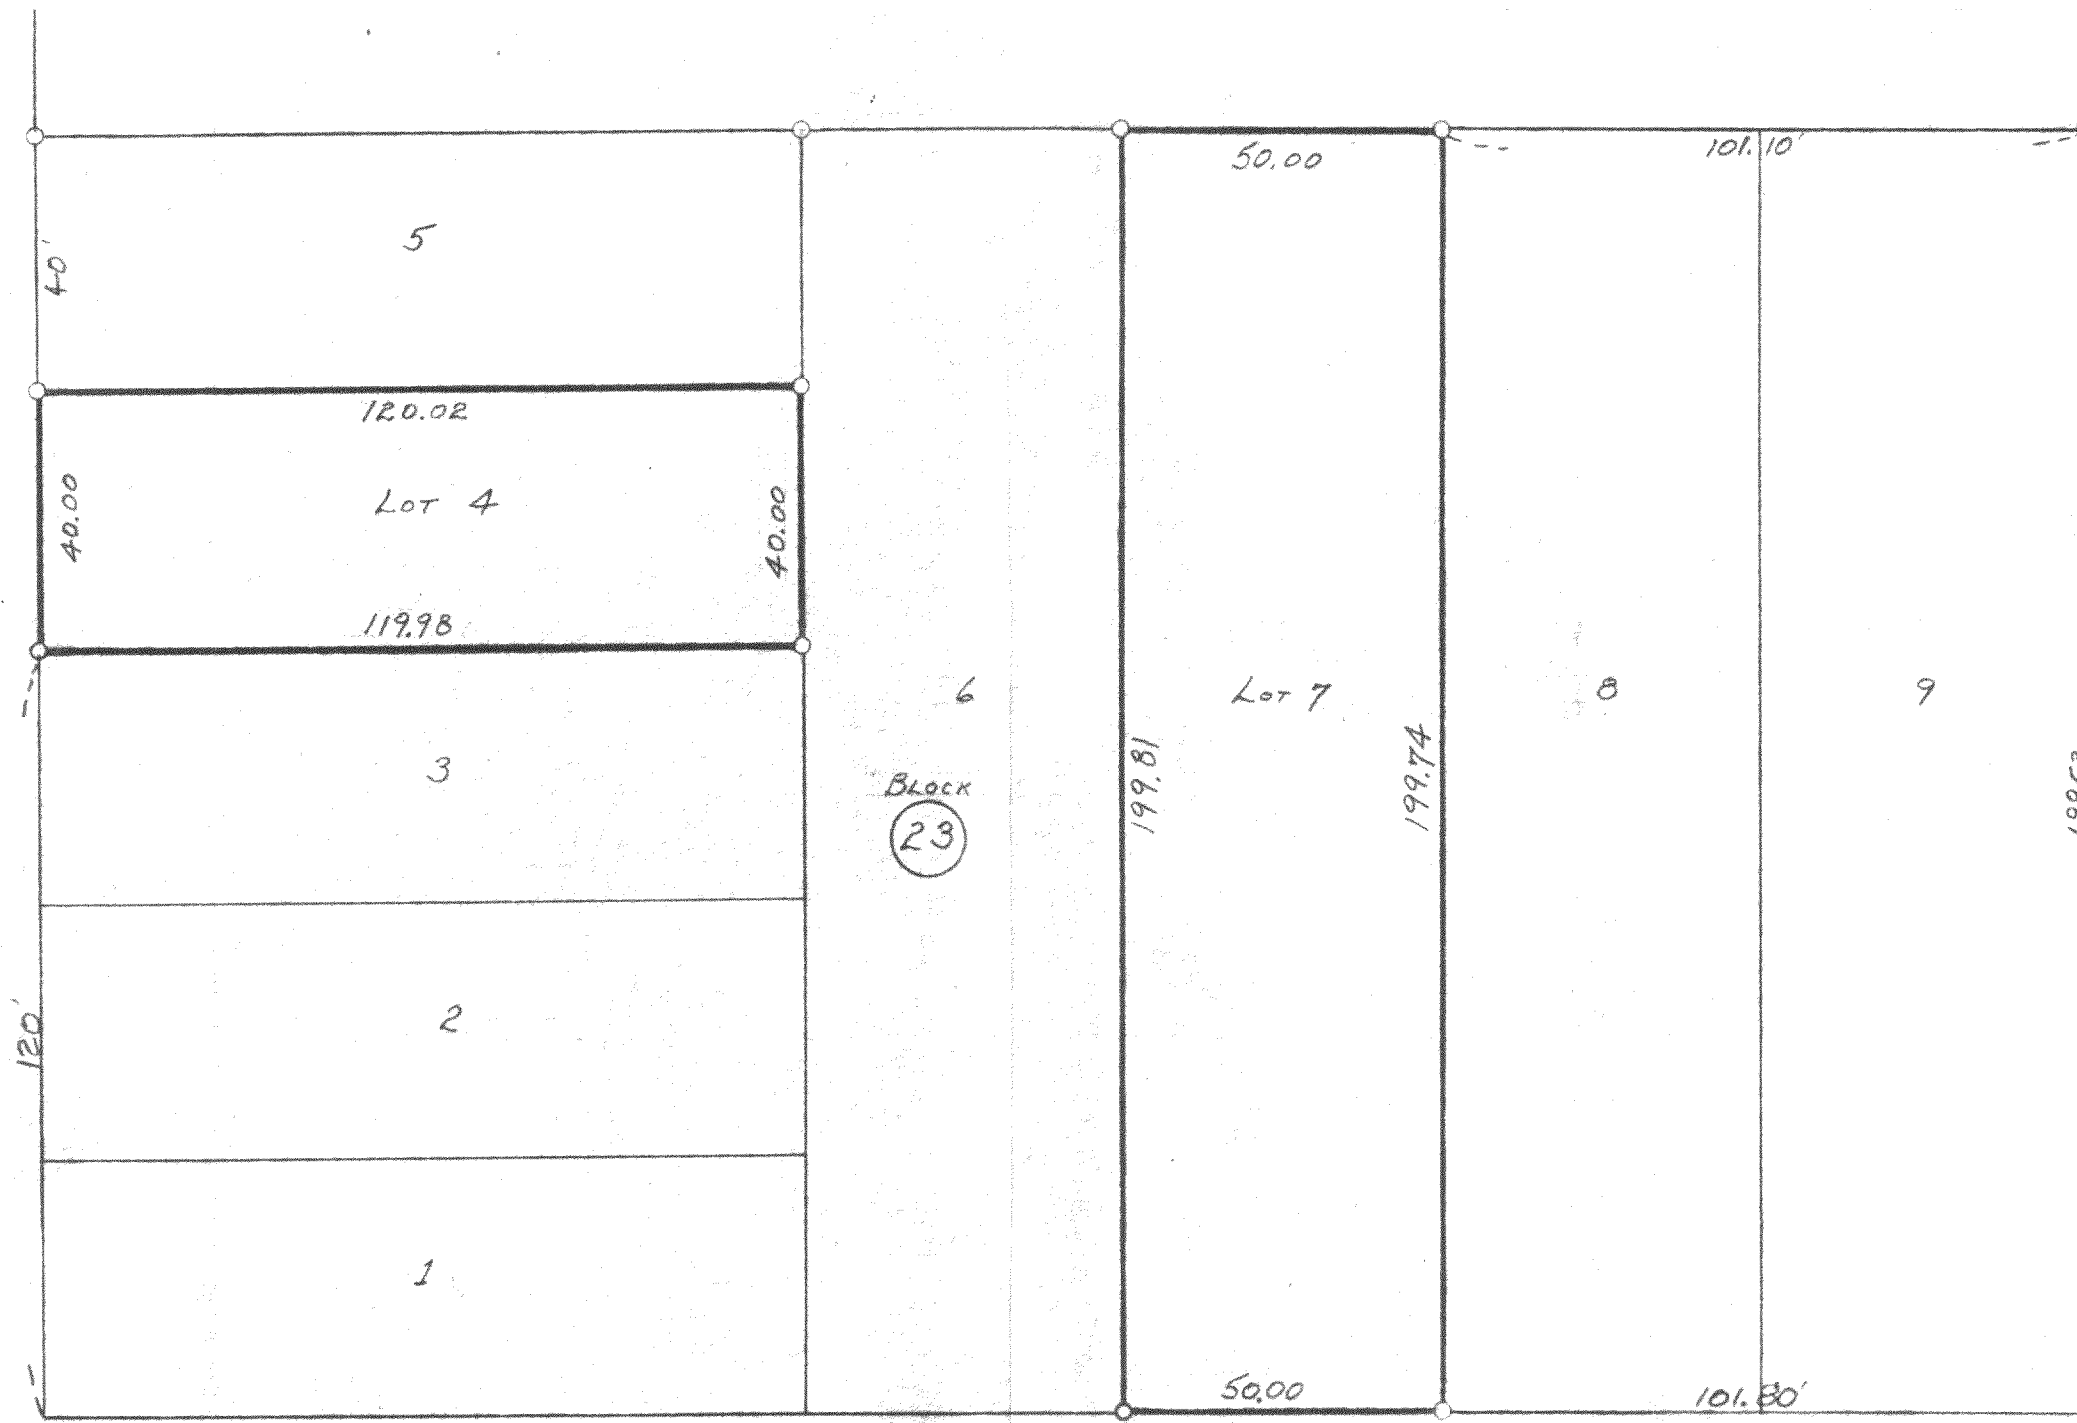

SOUTH VIEW DRIVE

PLAT OF SURVEY OF

LOTS 4 & 7
BLOCK 23

SUNSET HILLS

LOCATED IN

SECT 33, T2N R17E W2W CO., WISCONSIN

Lloyd L. Jensen
SURVEYOR

SCALE 1" = 30'

DATE JULY 1953

217-63.1