


WALWORTH COUNTY
SURVEYING & MAPPING
LAKE GENEVA, WISCONSIN

IRIS ROAD



BLOCK 105

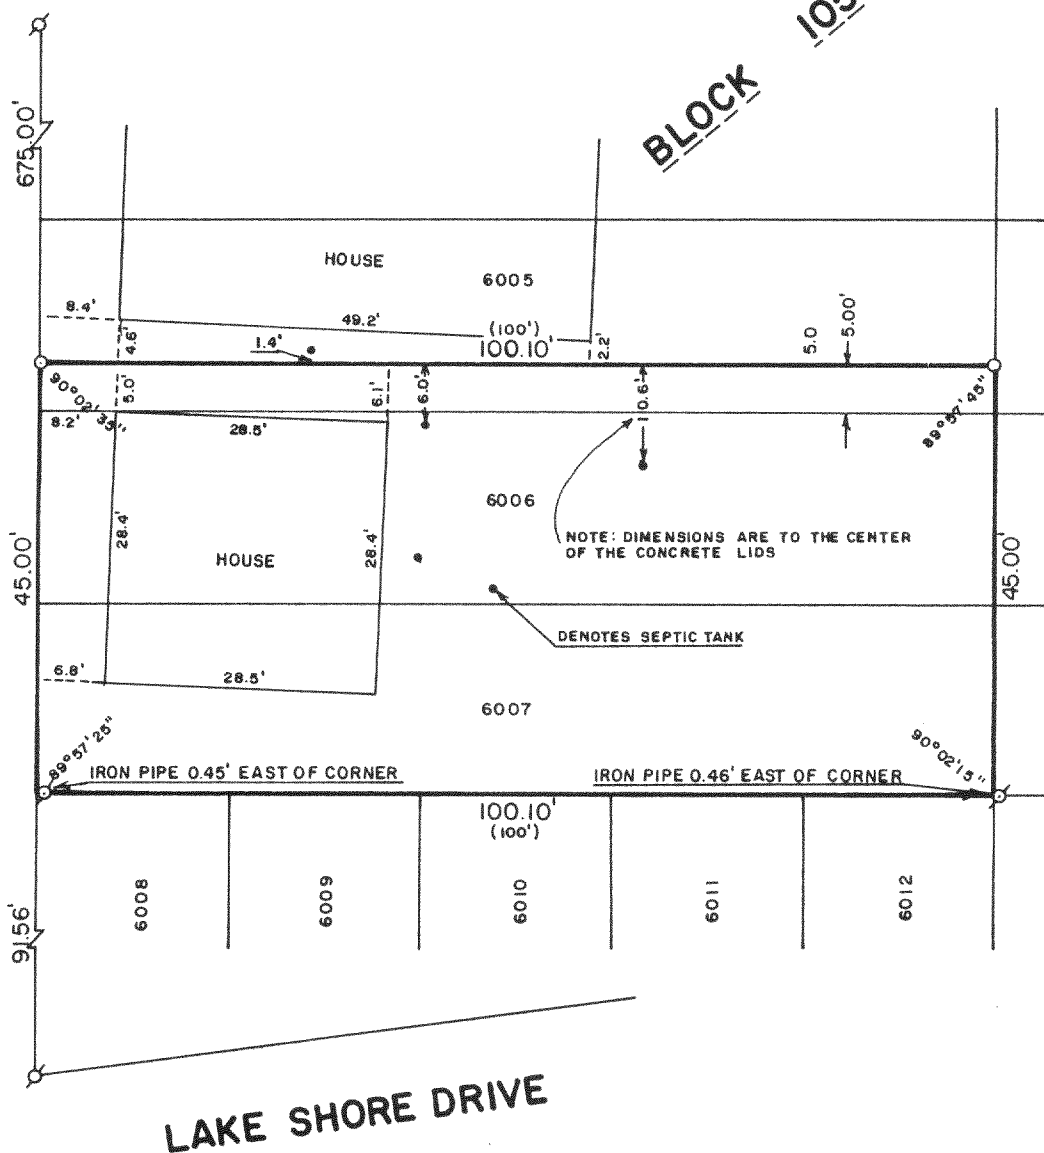

PLAT OF SURVEY OF

THE SOUTH 5 FEET OF LOT 6005 AND ALL OF
LOTS 6006 AND 6007, BLOCK 105 OF LAKE
COMO BEACH SUBDIVISION, LOCATED IN T 2 N,
R 17 E, WALWORTH COUNTY, WISCONSIN.

ORDERED BY: ROY CONANT
CARLSON ROAD
LAND O LAKES, WISCONSIN 54540

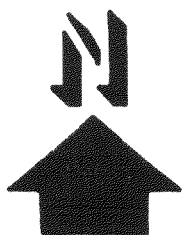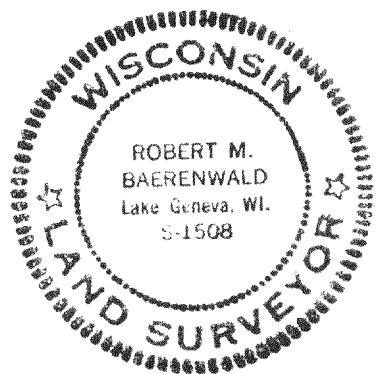

SCALE: 1"=20'

⊘ - IRON PIPE FOUND
○ - IRON ROD SET
() - RECORDED AS

I, ROBERT M. BAERENWALD, DO HEREBY CERTIFY THAT I
HAVE SURVEYED THE PROPERTY HEREON DESCRIBED ACCORDING
TO THE OFFICIAL RECORDS AND THAT THE PLAT HEREON IS A
CORRECT REPRESENTATION OF THE PROPERTY LINES TO THE
BEST OF MY KNOWLEDGE AND BELIEF.

Robert M. Baerenwald
ROBERT M. BAERENWALD
WISCONSIN REGISTERED LAND SURVEYOR, S-1508

May 1, 1986
DATE JOB NO. 0528

JCB-1235

217-630-B