


WALWORTH COUNTY
SURVEYING & MAPPING
LAKE GENEVA, WISCONSIN

DANDELION ROAD

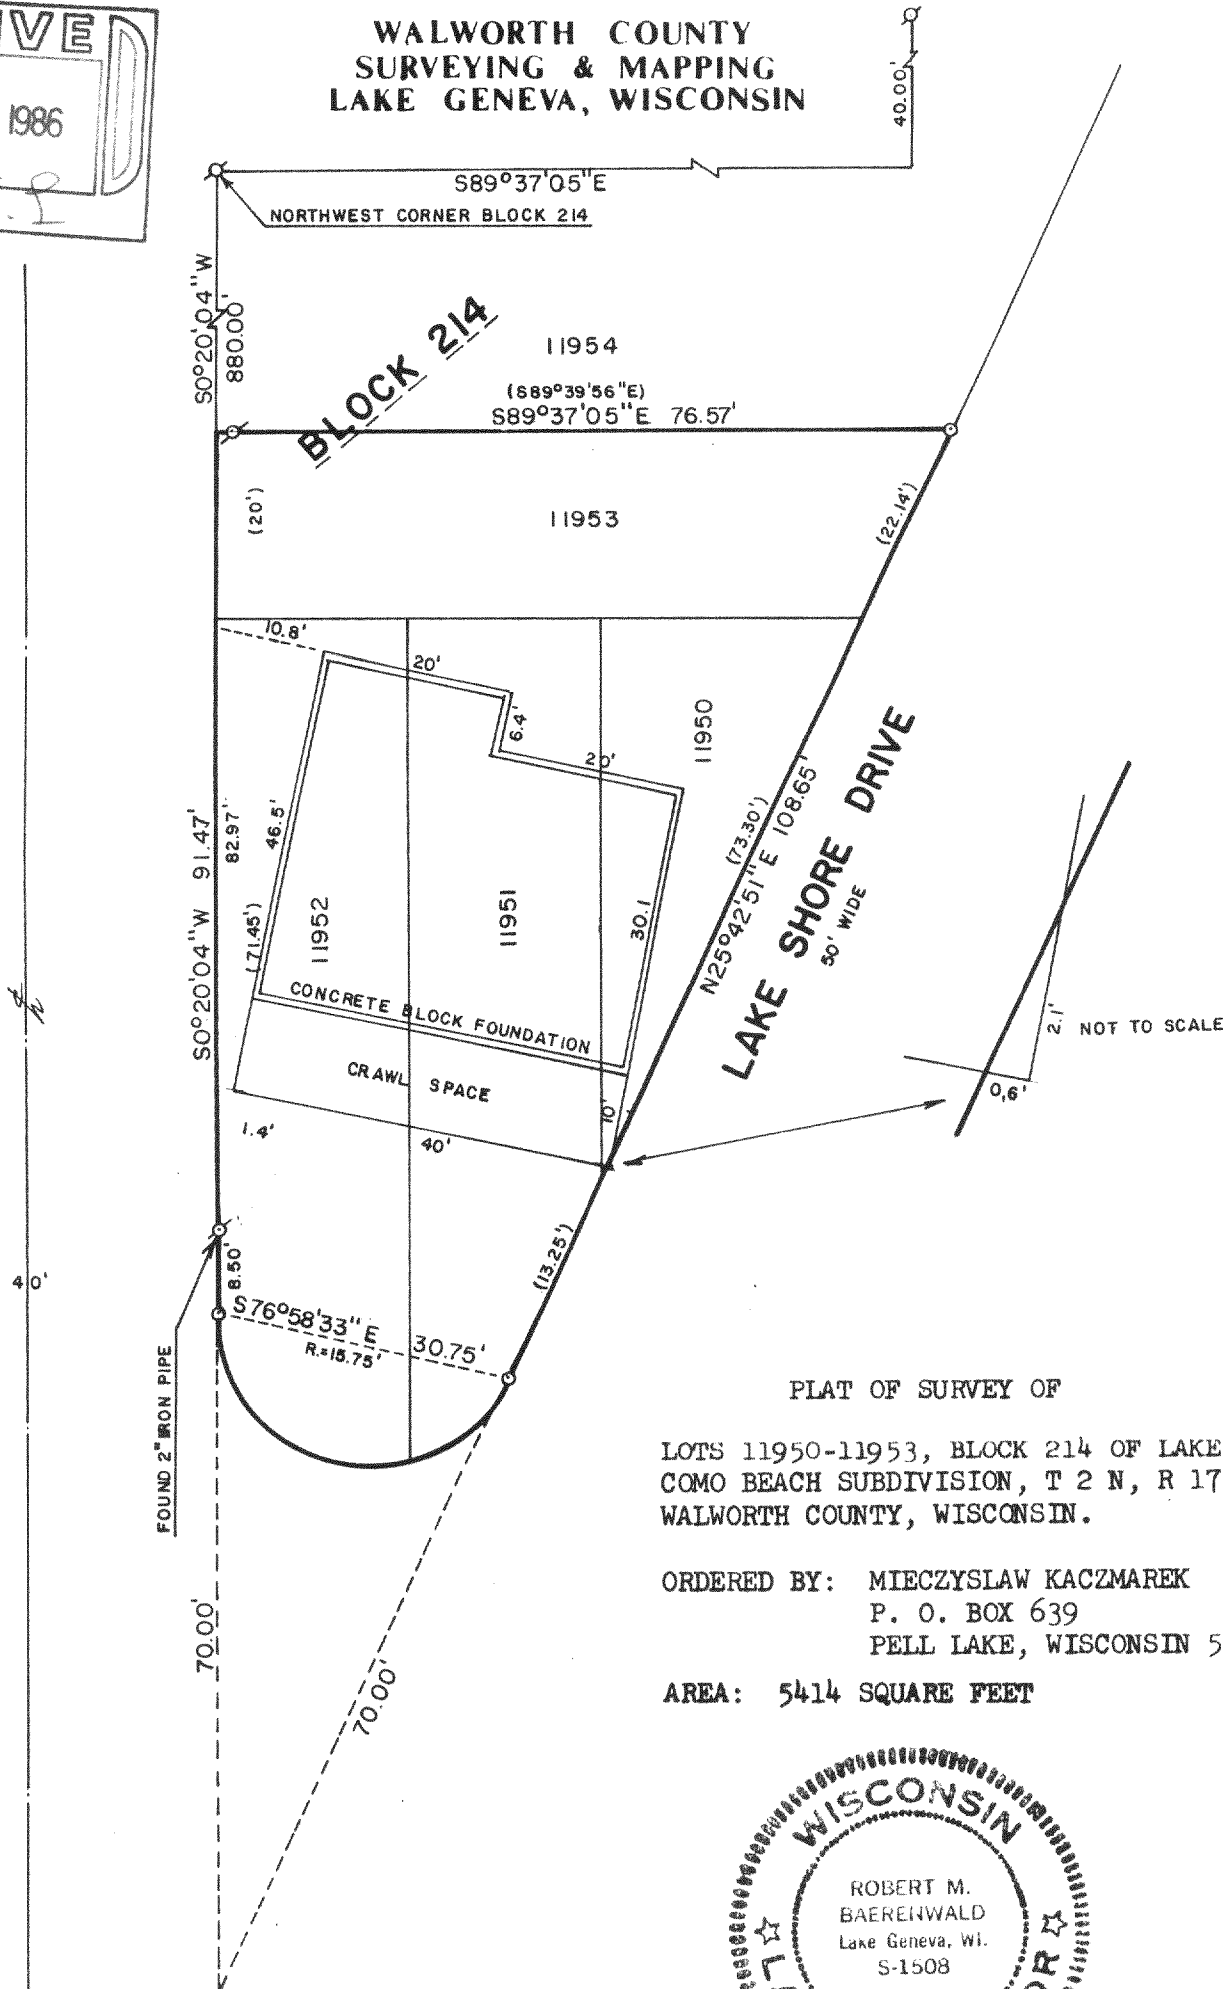


PLAT OF SURVEY OF

LOTS 11950-11953, BLOCK 214 OF LAKE
COMO BEACH SUBDIVISION, T 2 N, R 17 E,
WALWORTH COUNTY, WISCONSIN.

ORDERED BY: MIECZYSLAW KACZMAREK
P. O. BOX 639
PELL LAKE, WISCONSIN 53157

AREA: 5414 SQUARE FEET

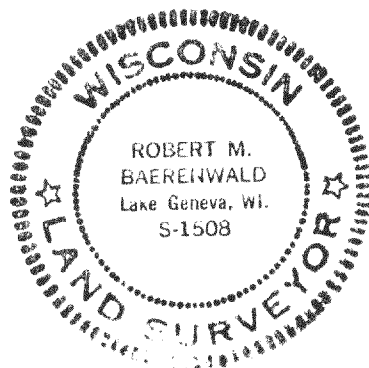

I, ROBERT M. BAERENWALD, DO HEREBY CERTIFY THAT I
HAVE SURVEYED THE PROPERTY HEREON DESCRIBED ACCORDING
TO THE OFFICIAL RECORDS AND THAT THE PLAT HEREON IS A
CORRECT REPRESENTATION OF THE PROPERTY LINES TO THE
BEST OF MY KNOWLEDGE AND BELIEF.

Robert M. Baerenwald
ROBERT M. BAERENWALD
WISCONSIN REGISTERED LAND SURVEYOR, S-1508

DATE *June 11, 1986* JOB NO. 0542
REVISED: JULY 23, 1986



SCALE: 1"=20'

⊘ - IRON PIPE FOUND
○ - IRON ROD SET
() - RECORDED AS

JLCB-02600

217-634