



WALWORTH COUNTY
SURVEYING & MAPPING
LAKE GENEVA, WISCONSIN

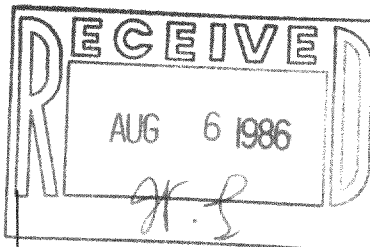

TAMARACK ROAD


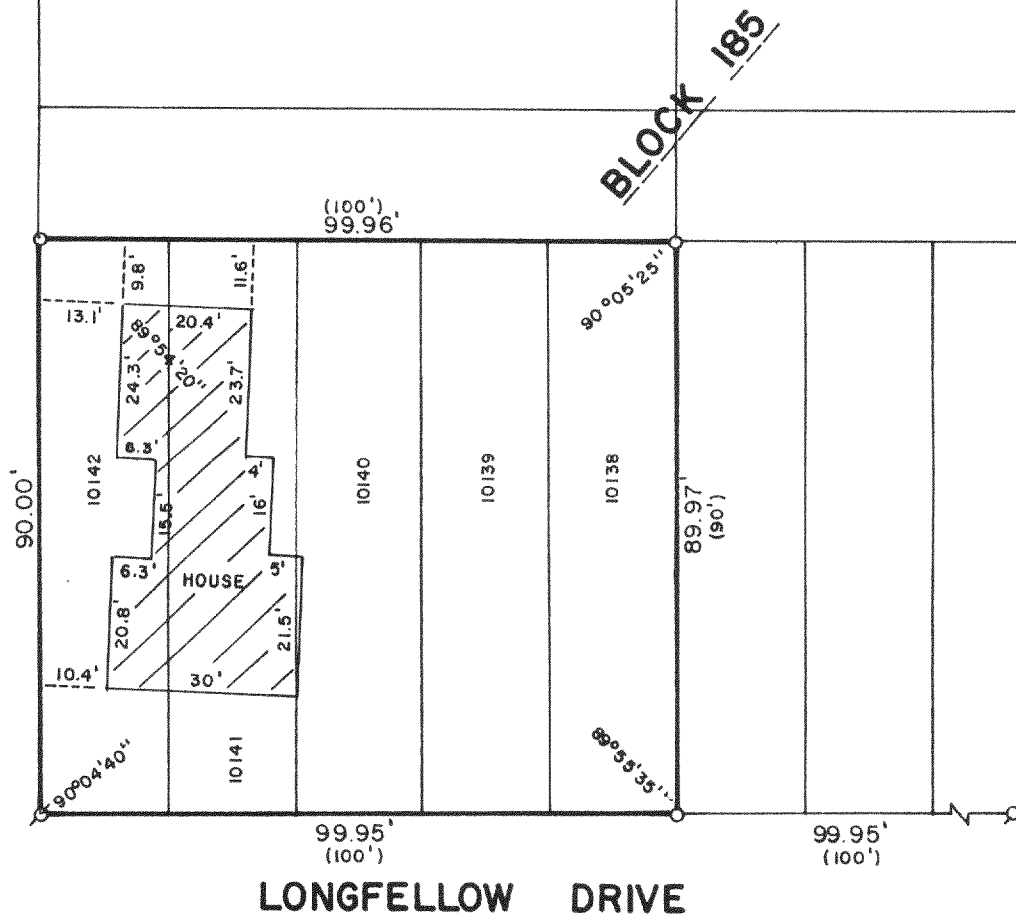


LONGFELLOW DRIVE

PLAT OF SURVEY OF

LOTS 10138-10142, INCLUSIVE, BLOCK 185
OF LAKE COMO BEACH SUBDIVISION, T 2 N,
R 17 E, WALWORTH COUNTY, WISCONSIN.

ORDERED BY: CENTURY 21
LAKE GENEVA, WISCONSIN 53147

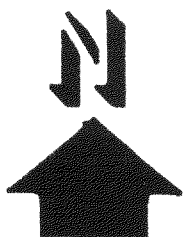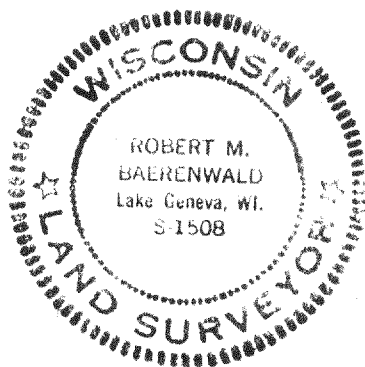

SCALE: 1"=30'

⊙ - IRON PIPE FOUND
○ - IRON ROD PLACED
() - RECORDED AS

I, ROBERT M. BAERENWALD, DO HEREBY CERTIFY THAT I
HAVE SURVEYED THE PROPERTY HEREON DESCRIBED ACCORDING
TO THE OFFICIAL RECORDS AND THAT THE PLAT HEREON IS A
CORRECT REPRESENTATION OF THE PROPERTY LINES TO THE
BEST OF MY KNOWLEDGE AND BELIEF.

Robert M. Baerenwald
ROBERT M. BAERENWALD
WISCONSIN REGISTERED LAND SURVEYOR, S-1508

DATE *July 25, 1986*
JOB NO. 0662

JLCB-02190

217-636