


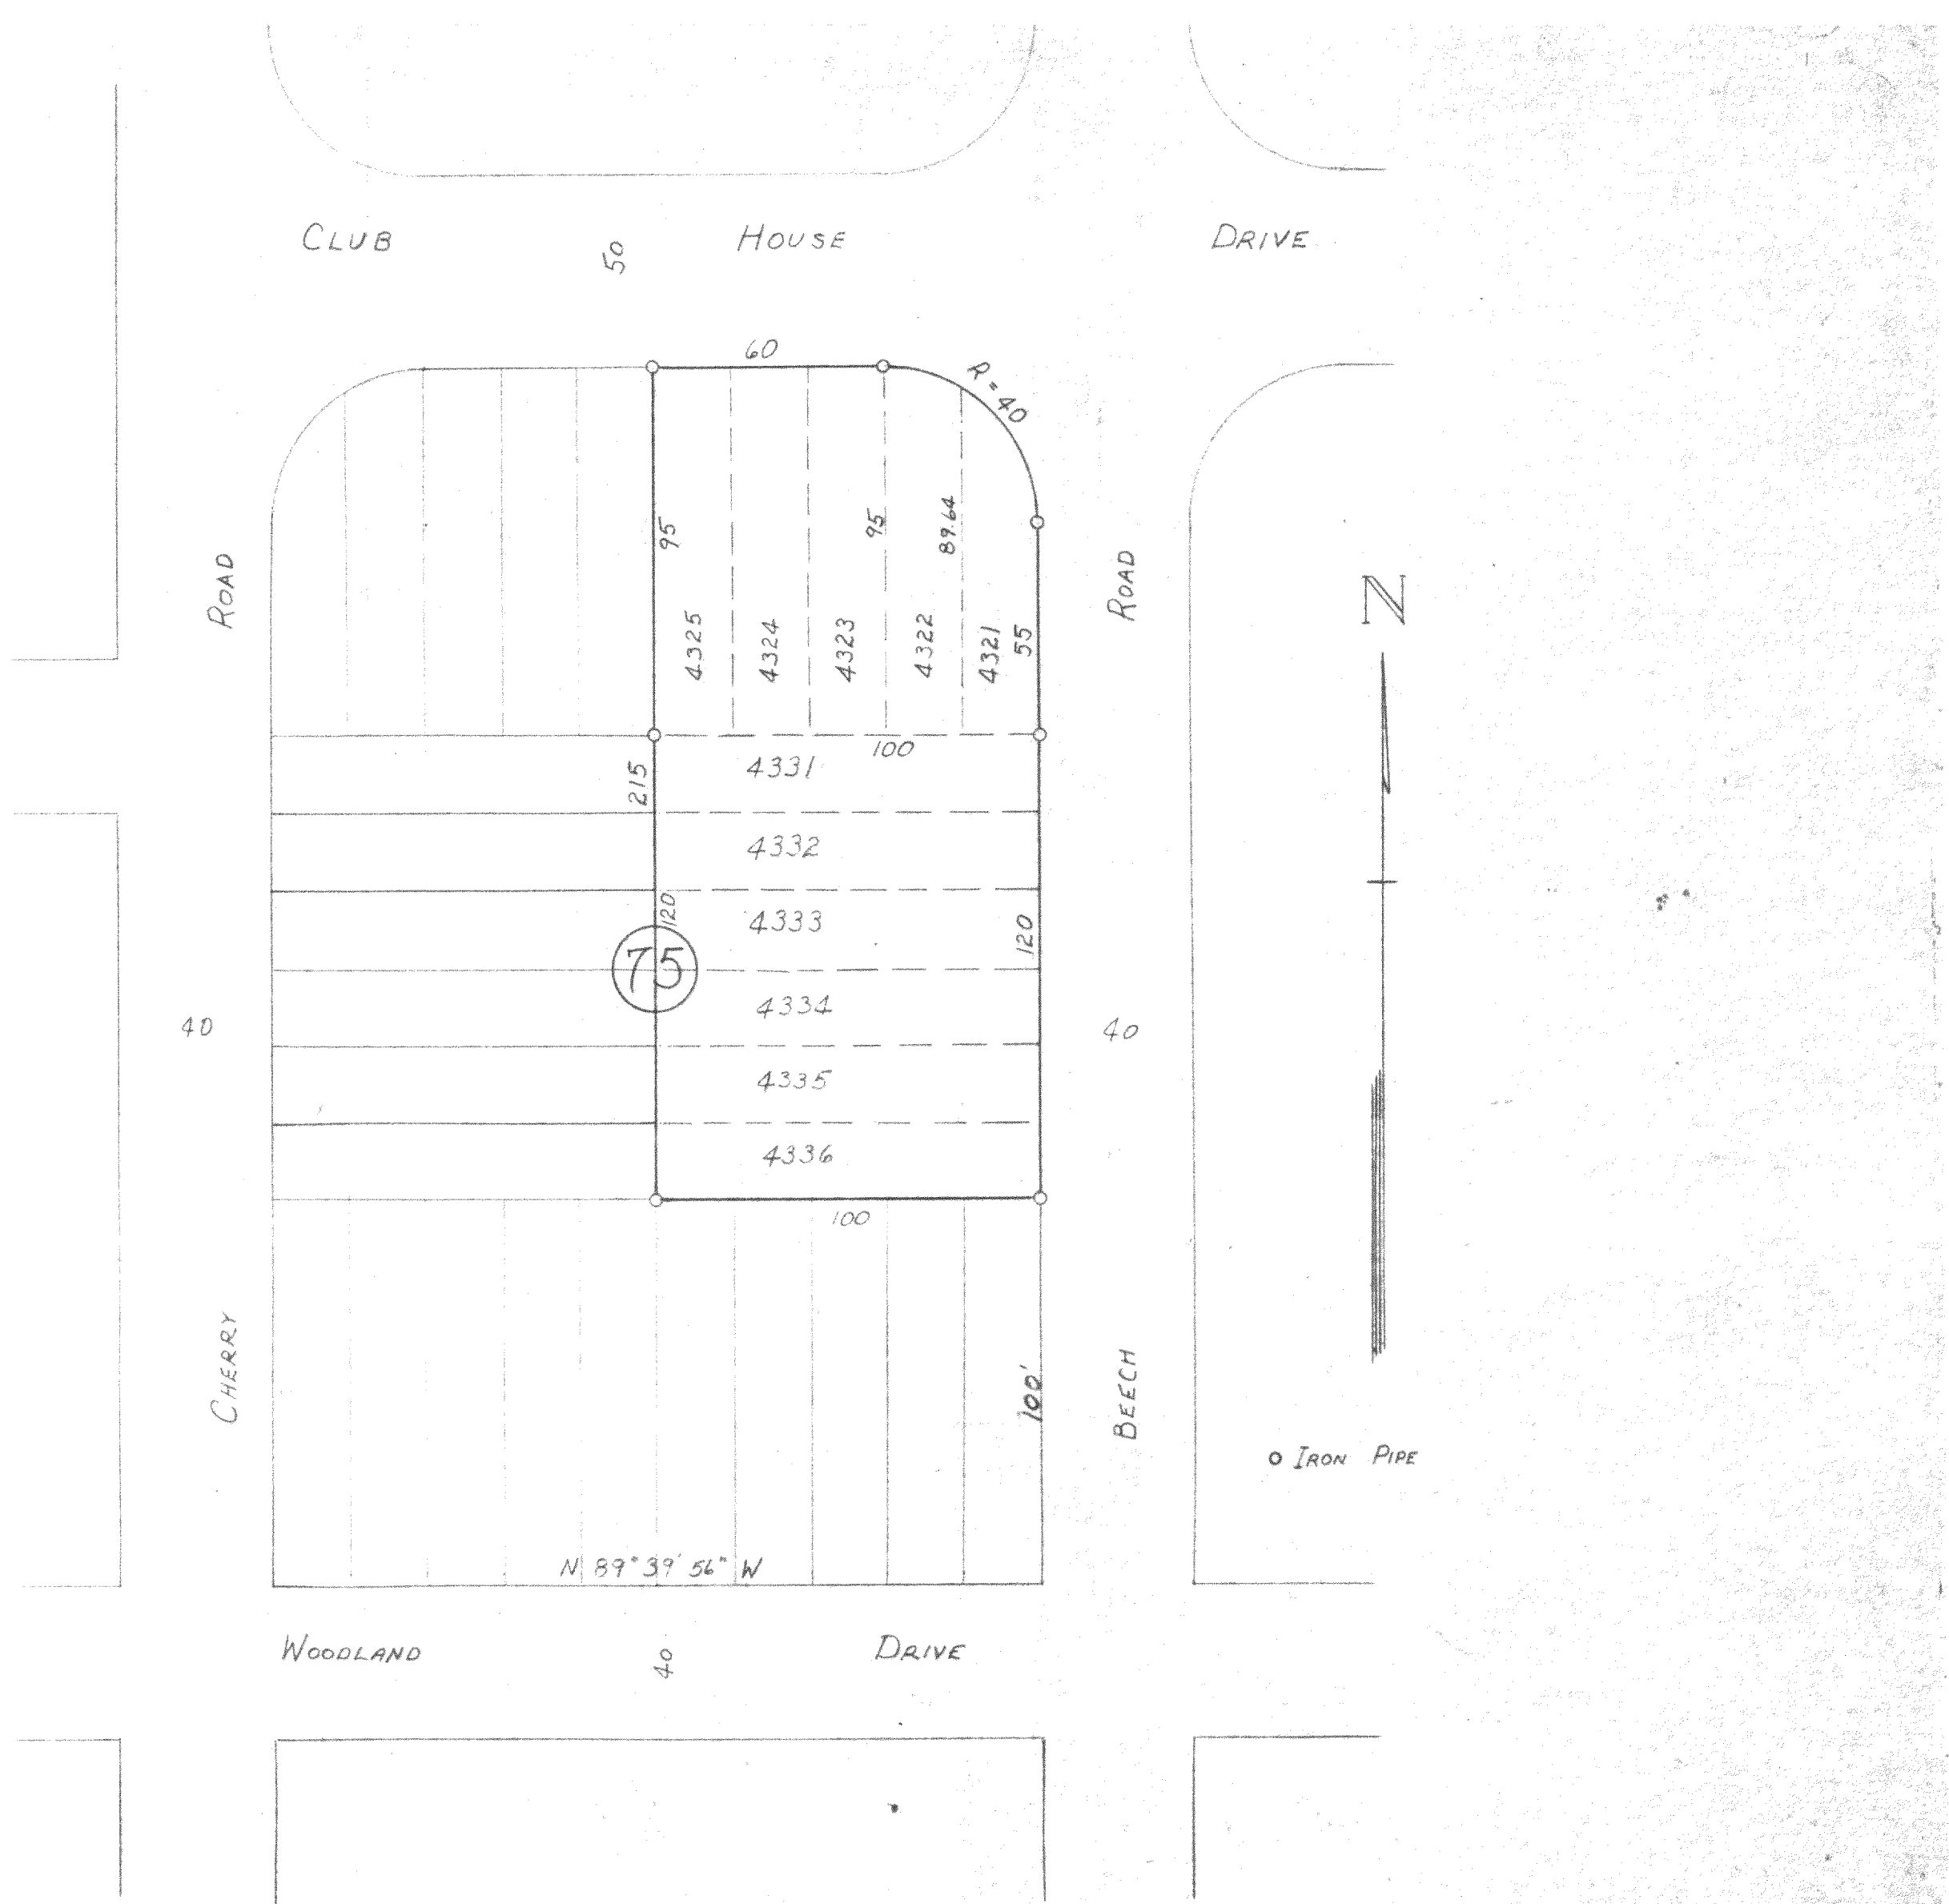

PLAT OF SURVEY OF

Lot Nos. 4321 - 4325 (Incl)
AND

Lot Nos. 4331 - 4336 (Incl)

SECOND MAP OF LAKE COND BEACH
WALWORTH COUNTY, WISCONSIN

Raymond L. Jensen
SURVEYOR

SCALE 1" = 40'

DATE APRIL 7, 1953

JLCB-843

217-65.1