



DUNHAM SURVEYING, S.C.
SURVEYING & SUBDIVIDING
DELAVER, WISCONSIN 53115

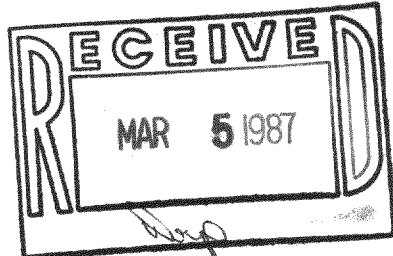

Scale - 1" = 20'
 • = 2" Iron Pipe Found
 ◐ = 1" Iron Pipe Found
 ◑ = 3/4" Iron Pipe Found
 ◒ = 1" Iron Pipe Set
 ◓ = 1/2" X 24" Iron Pipe Set
 (0.00) = recorded distance
 Survey ordered by:
 David P. Wrobel
 306 W. Northwest Highway
 Barrington, IL 60010

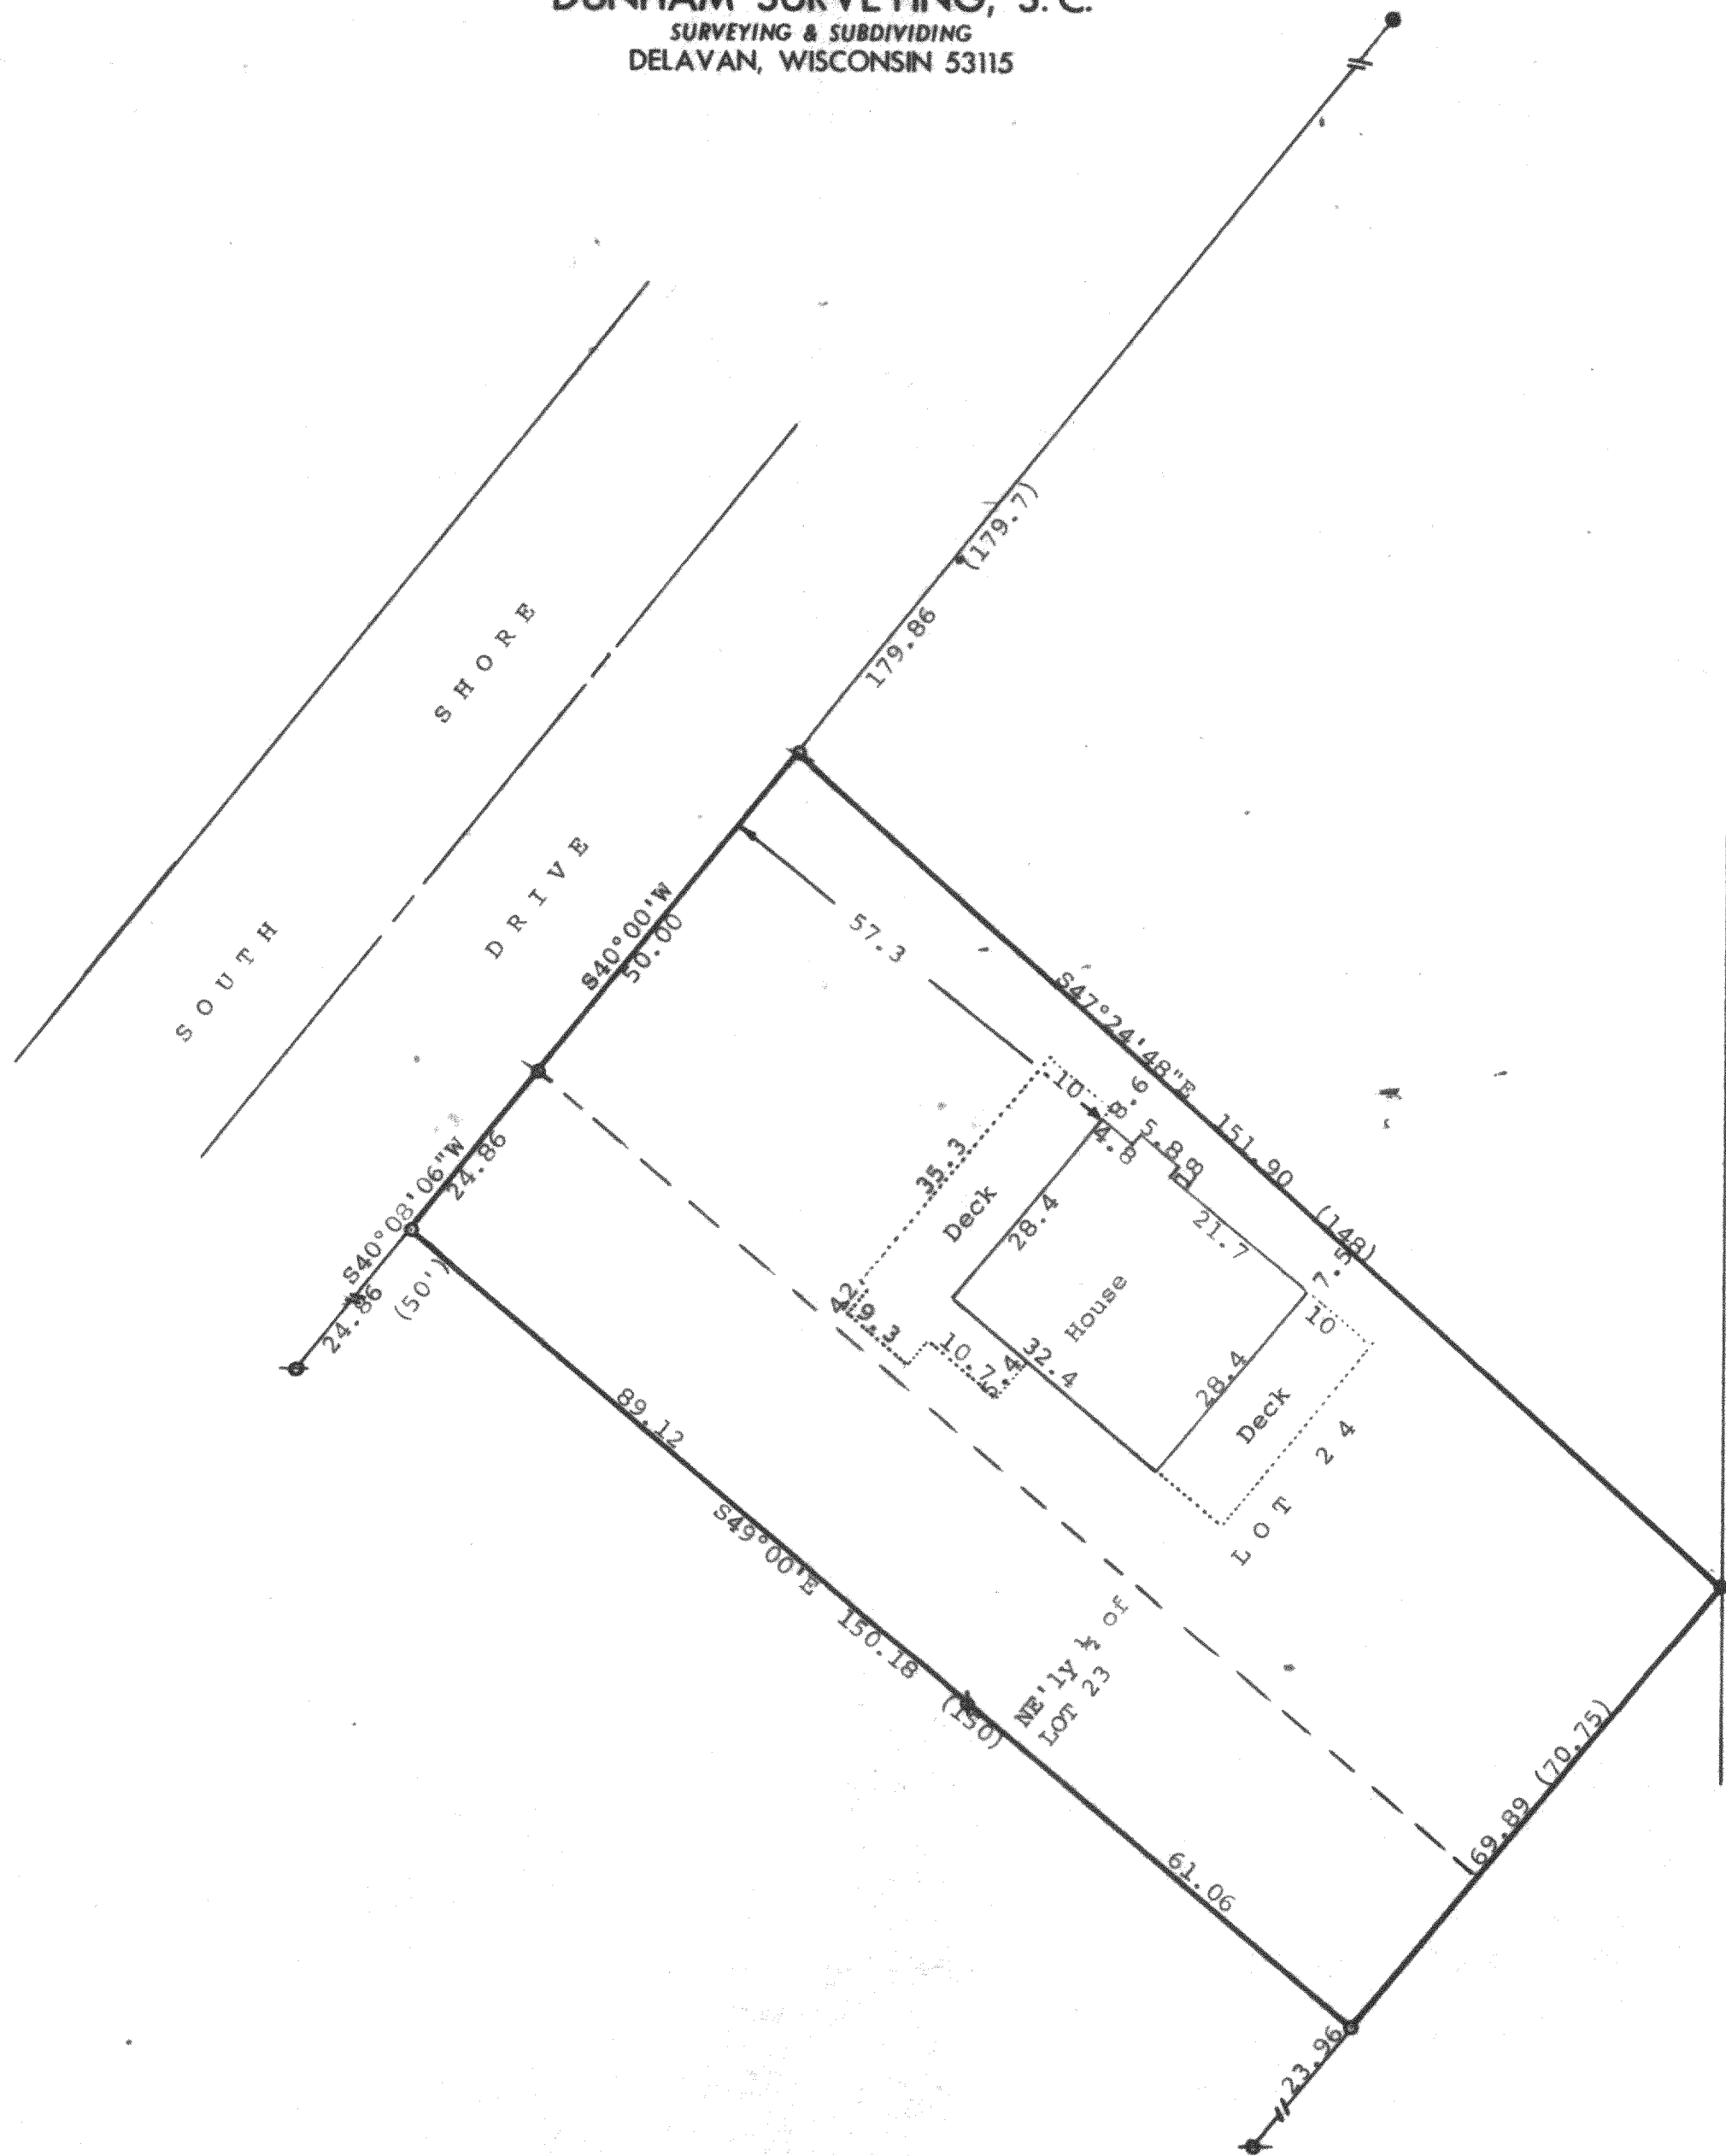

STATE OF WISCONSIN) SS
 COUNTY OF WALWORTH)

I, George T. Dunham, Surveyor, certify that I have surveyed the property described as follows:

Lot 24 and the Northeast 1/4 of Lot 23 in Como Vista Subdivision, located in the Town of Geneva, Walworth County, Wisconsin, and that the map shown above is a correct representation thereof and shows the size and location of the property, its exterior boundaries, the location of all visible structures and dimensions of all principal buildings thereon, boundary fences, apparent easements, roadways and visible encroachments, if any, and that I have surveyed the property hereon described according to the official records, to the best of my knowledge and belief.
 Sept. 10, 1986

George T. Dunham
 George T. Dunham, Surveyor

