




OF LOT 11 BLOCK THREE OF HAWTHORNE HILLS SUBDIVISION LOCATED IN THE N.E.  $\frac{1}{4}$  OF THE S.W.  $\frac{1}{4}$  AND THE S.E.  $\frac{1}{4}$  OF THE N.W.  $\frac{1}{4}$  OF SECTION 26, T2N, R17E, WALWORTH COUNTY, WISCONSIN.

Prepared for: Richard Weber  
N 675 Grandview Dr.  
Rt. 4 Box 186  
Lake Geneva, WI.

Prepared by: JENSEN SURVEYING & MAPPING S.C.  
P.O. Box 322  
Elkhorn, WI. 53121

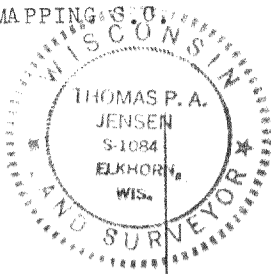

Copyright © 1987 by Jensen Surveying & Mapping S.C.  
All rights reserved. No part of this survey plat may be reproduced or transmitted in any form by any means - graphic, electronic, or mechanical, including photocopying, tracing, or information storage and retrieval systems - without permission in writing from Thomas P.A. Jensen, Jensen-Surveying & Mapping S.C.

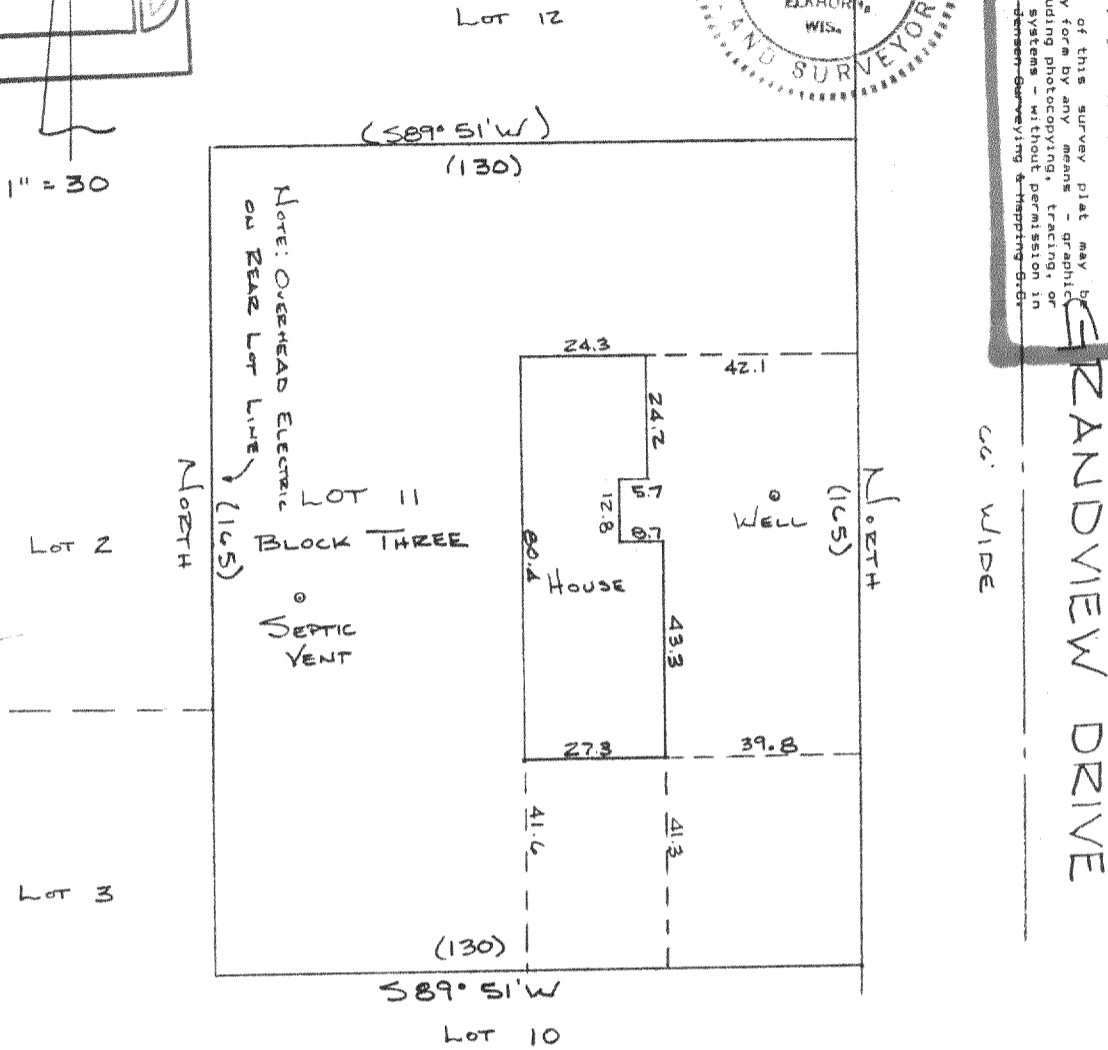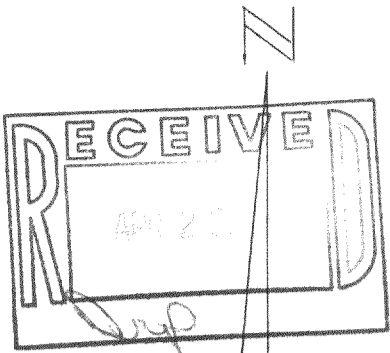

DO NOT photocopy

NOTE: In accordance with A-E 5.01 (1)(b) this inspection has been exempted from the requirements of A-E 5.01, Minimum Requirements for Property Surveys. Lot dimensions are shown as recorded on the subdivision plat. These dimensions were not necessarily verified in the field and no lot stakes were set in the course of this inspection. This inspection does not constitute a complete property survey and cannot be relied on as such.

**CERTIFICATION**

I certify that the property described above has been inspected under my responsible direction and supervision and that the above map is an accurate representation of the size and location of the property and the location and dimensions of all visible improvements, if any.

This inspection is made for the exclusive use of the present owners of the property and also those who purchase, mortgage, or guarantee the title thereto, and is certified for one year from the date shown hereon.

DATE: DEC. 18, 1986

1986.139

*Thomas P. A. Jensen*  
 THOMAS P.A. JENSEN S-1084